


Map For Claim of Beneficial Use

Sections 15, 16, & 21, T5S, R3W, Yamhill County



1 IN = 1320 FT
0 660 1320

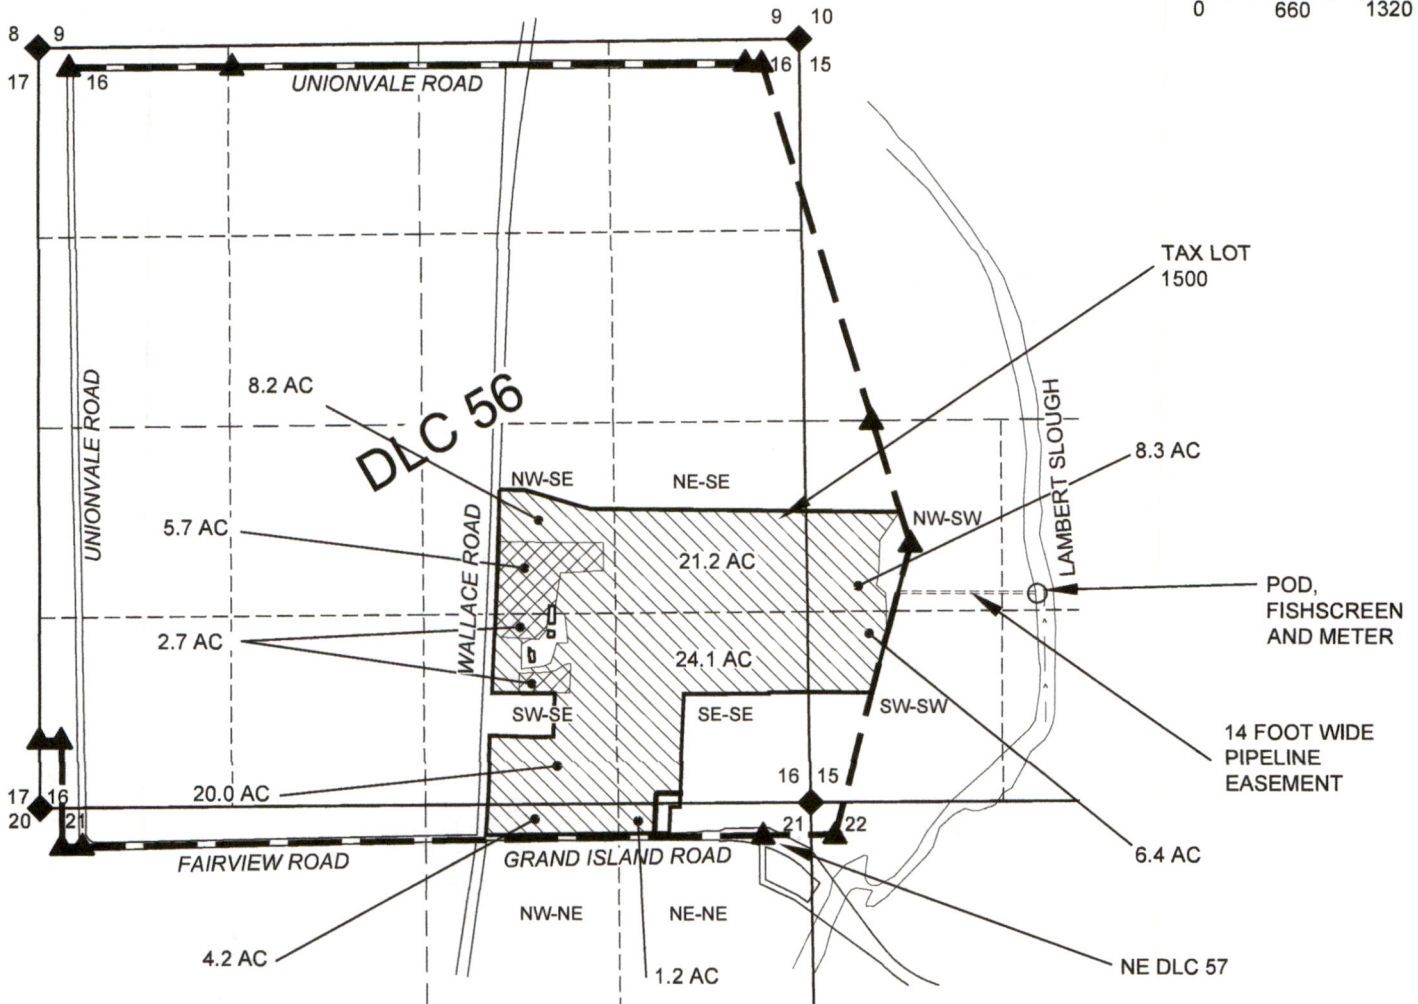


THE POD IS 1660' NORTH AND 1890' EAST FROM THE NE CORNER DLC 57.

NOTES:

- THIS MAP IS NOT INTENDED TO PROVIDE LEGAL DIMENSIONS OR LOCATIONS OF PROPERTY OWNERSHIP LINES.
- PROPERTY LINES ARE BASED ON COUNTY SURVEY CS-11487. SECTION, QUARTER-QUARTER, AND DONATION LAND CLAIM LINES ARE BASED ON THE TAX ASSESSOR MAP FOR SECTION 16, T5S, R3W.
- IRRIGATION AREAS AND THE POD LOCATION ARE BASED ON A SITE VISIT AND A MARCH 2024 GOOGLE AERIAL PHOTO.

LEGEND

- DONATION LAND CLAIM (DLC) CORNER
- SECTION CORNER
- POINT OF DIVERSION (POD)
- STREAM OR SURFACE DRAINAGE
- TAX LOT LINE
- SECTION LINE
- QUARTER-QUARTER LINE
- DLC LINES
- IRRIGATION
- SUPPL (TO 85048)

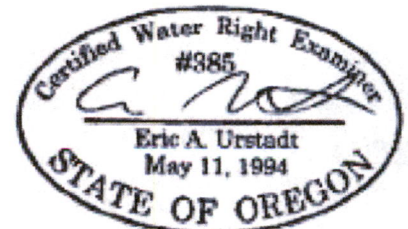

Exp. 30 Jun 2026

Received
MAR 13 2025
OWRD

MAP BY:
ASPEN RURAL LAND CONSULTING
ERIC URSTADT, PE, PLS
971-250-1520
OCT 2023
WVL-SBKing4D