


RECEIVED  
MAY 02 2023  
OWRD

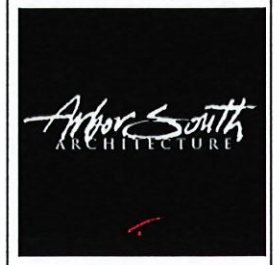

380 Lincoln Street  
Eugene, Oregon 97401  
Phone: 541-344-3332  
www.arborsouth.com

PROJECT  
NORTHWOOD  
CHRISTIAN CHURCH

2425 V STREET  
SPRINGFIELD OR

INDEX  
Site Plan - Well

JOB NO  
0520

DATE  
02 May 2023

DRAWN BY  
Bill

CHECKED BY  
Bill


REVISION



MEMBERS OF THE  
AMERICAN INSTITUTE  
OF ARCHITECTS

SHEET NO


0

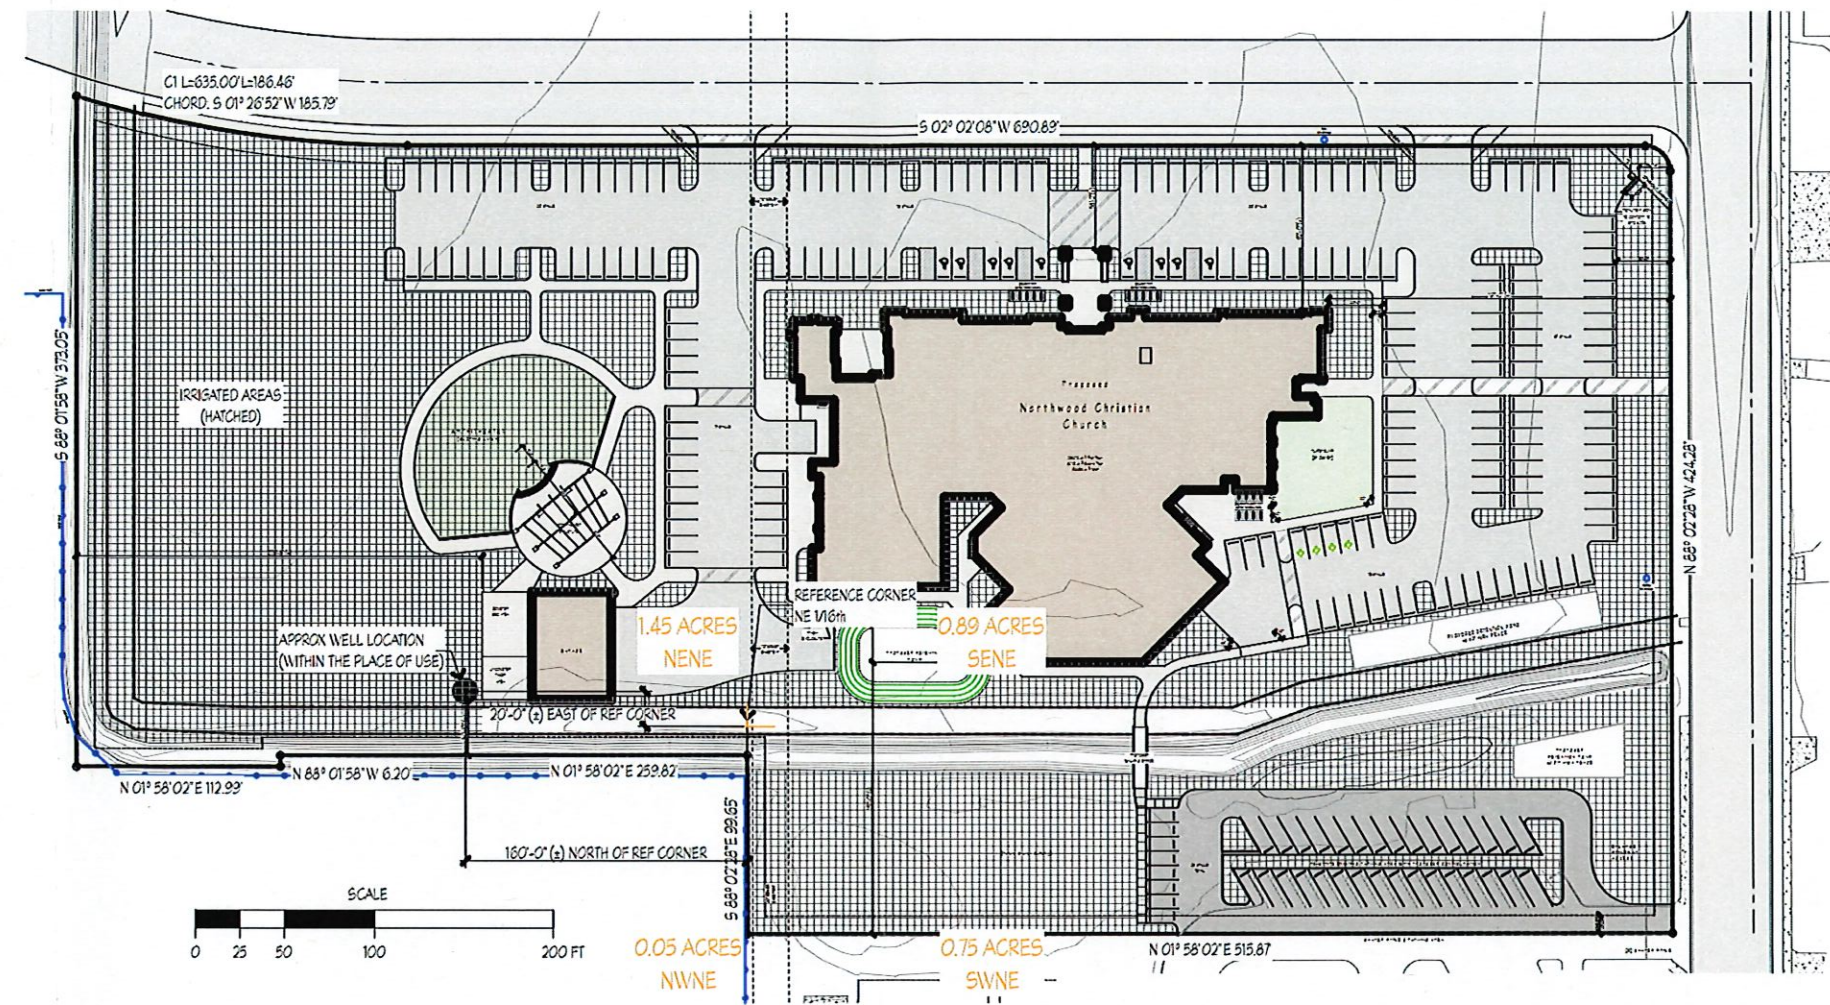

PLANTING AREA CALCULATIONS


TOTAL IRRIGATED AREA  
IS 3.14 ACRES

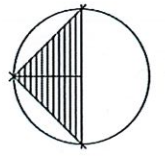

WELL LOCATION

SCALE: 1" = 100'

T17S R3W SEC 25 QTR SEC 11 TAX LOT 02300

Superseding