

Approved:



MEMO

To: Kristopher Byrd, Well Construction Manager
From: Tommy Laird, Well Construction Program Coordinator
Subject: Review of Water Right Application G-19386
Date: March 10, 2025

The attached application was forwarded to the Well Construction Section by the Groundwater Section. Gabriela Ferreira reviewed the application. Please see Gabriela's Groundwater Review and the Well Report.

Applicant's Well #Well 1 (CLAC 12526): Based on a review of the Well Report, Applicant's Well 1 seems to protect the groundwater resource.

The construction of Well 1 may not satisfy hydraulic connection issues.

Applicant's Well #Well 2 (Proposed): Well 2 is a proposed well, therefore it cannot be reviewed for construction. Construction of this proposed well shall be completed in a manner that protects ground water resources as required under Oregon Administrative Rules 690-200 through 690-240. During construction of this well, specific attention should be paid to ensure sealing requirements are met and that the well does not commingle aquifers.

The construction of proposed Well 2 may not satisfy hydraulic connection issues.

RECEIVED
No 3970

"START CARD"

NOTICE OF BEGINNING OF WELL CONSTRUCTION

(as required by ORS 537.762)

APR 25 1988

WATER RESOURCES DEPT.
SALEM, OREGON

This form must be completed, signed by both the owner (or authorized agent) and constructor, and the original delivered to the Water Resources Department prior to commencement of construction, alteration or abandonment of each well.

Owner's Name and
Mailing Address

Roy Miller
10581 S. Heing Rd.
Canby, Or. 97013

Proposed Commencement Date

4-25-88

Proposed Well Depth

100ft.

Diameter

6 in

and Use:

☒ Domestic☐ Community☐ Industrial☐ Irrigation☐ Thermal☐ Injection☐ Other

Proposed Well Location:

County

Clackamas

Township

4

(N or S)

Range

1

(E or W)

Section

26

At least 2
of these
must be
provided

1. NE 1/4 of SW 1/4 of above section2. street address of
well location10581 S. Heing Rd.
Canby, Or. 97013

3. tax lot number of well location

7004. attach approved map with location identified.
(see reverse of this form for approved maps)

We hereby certify that we have read the back of this form, and that to the best of our knowledge the information provided herein is accurate and the well is being properly located from septic tanks and septic drain fields.

x Roy Miller
Owner's Signature

x George J. Hainwright
Bonded Water Well Constructor

Owner
Title

License No. 637

Apr. 22-88
Date


Company B+S Well Drilling

Note: This is not a Water Right application. The owner is responsible for obtaining a Water Right through the Water Resources Department if required.

THIS MAP WAS PREPARED FOR
ASSESSMENT PURPOSES ONLY

$1'' = 400'$

CANCELLED TAX LOTS
TL 300
1400AI

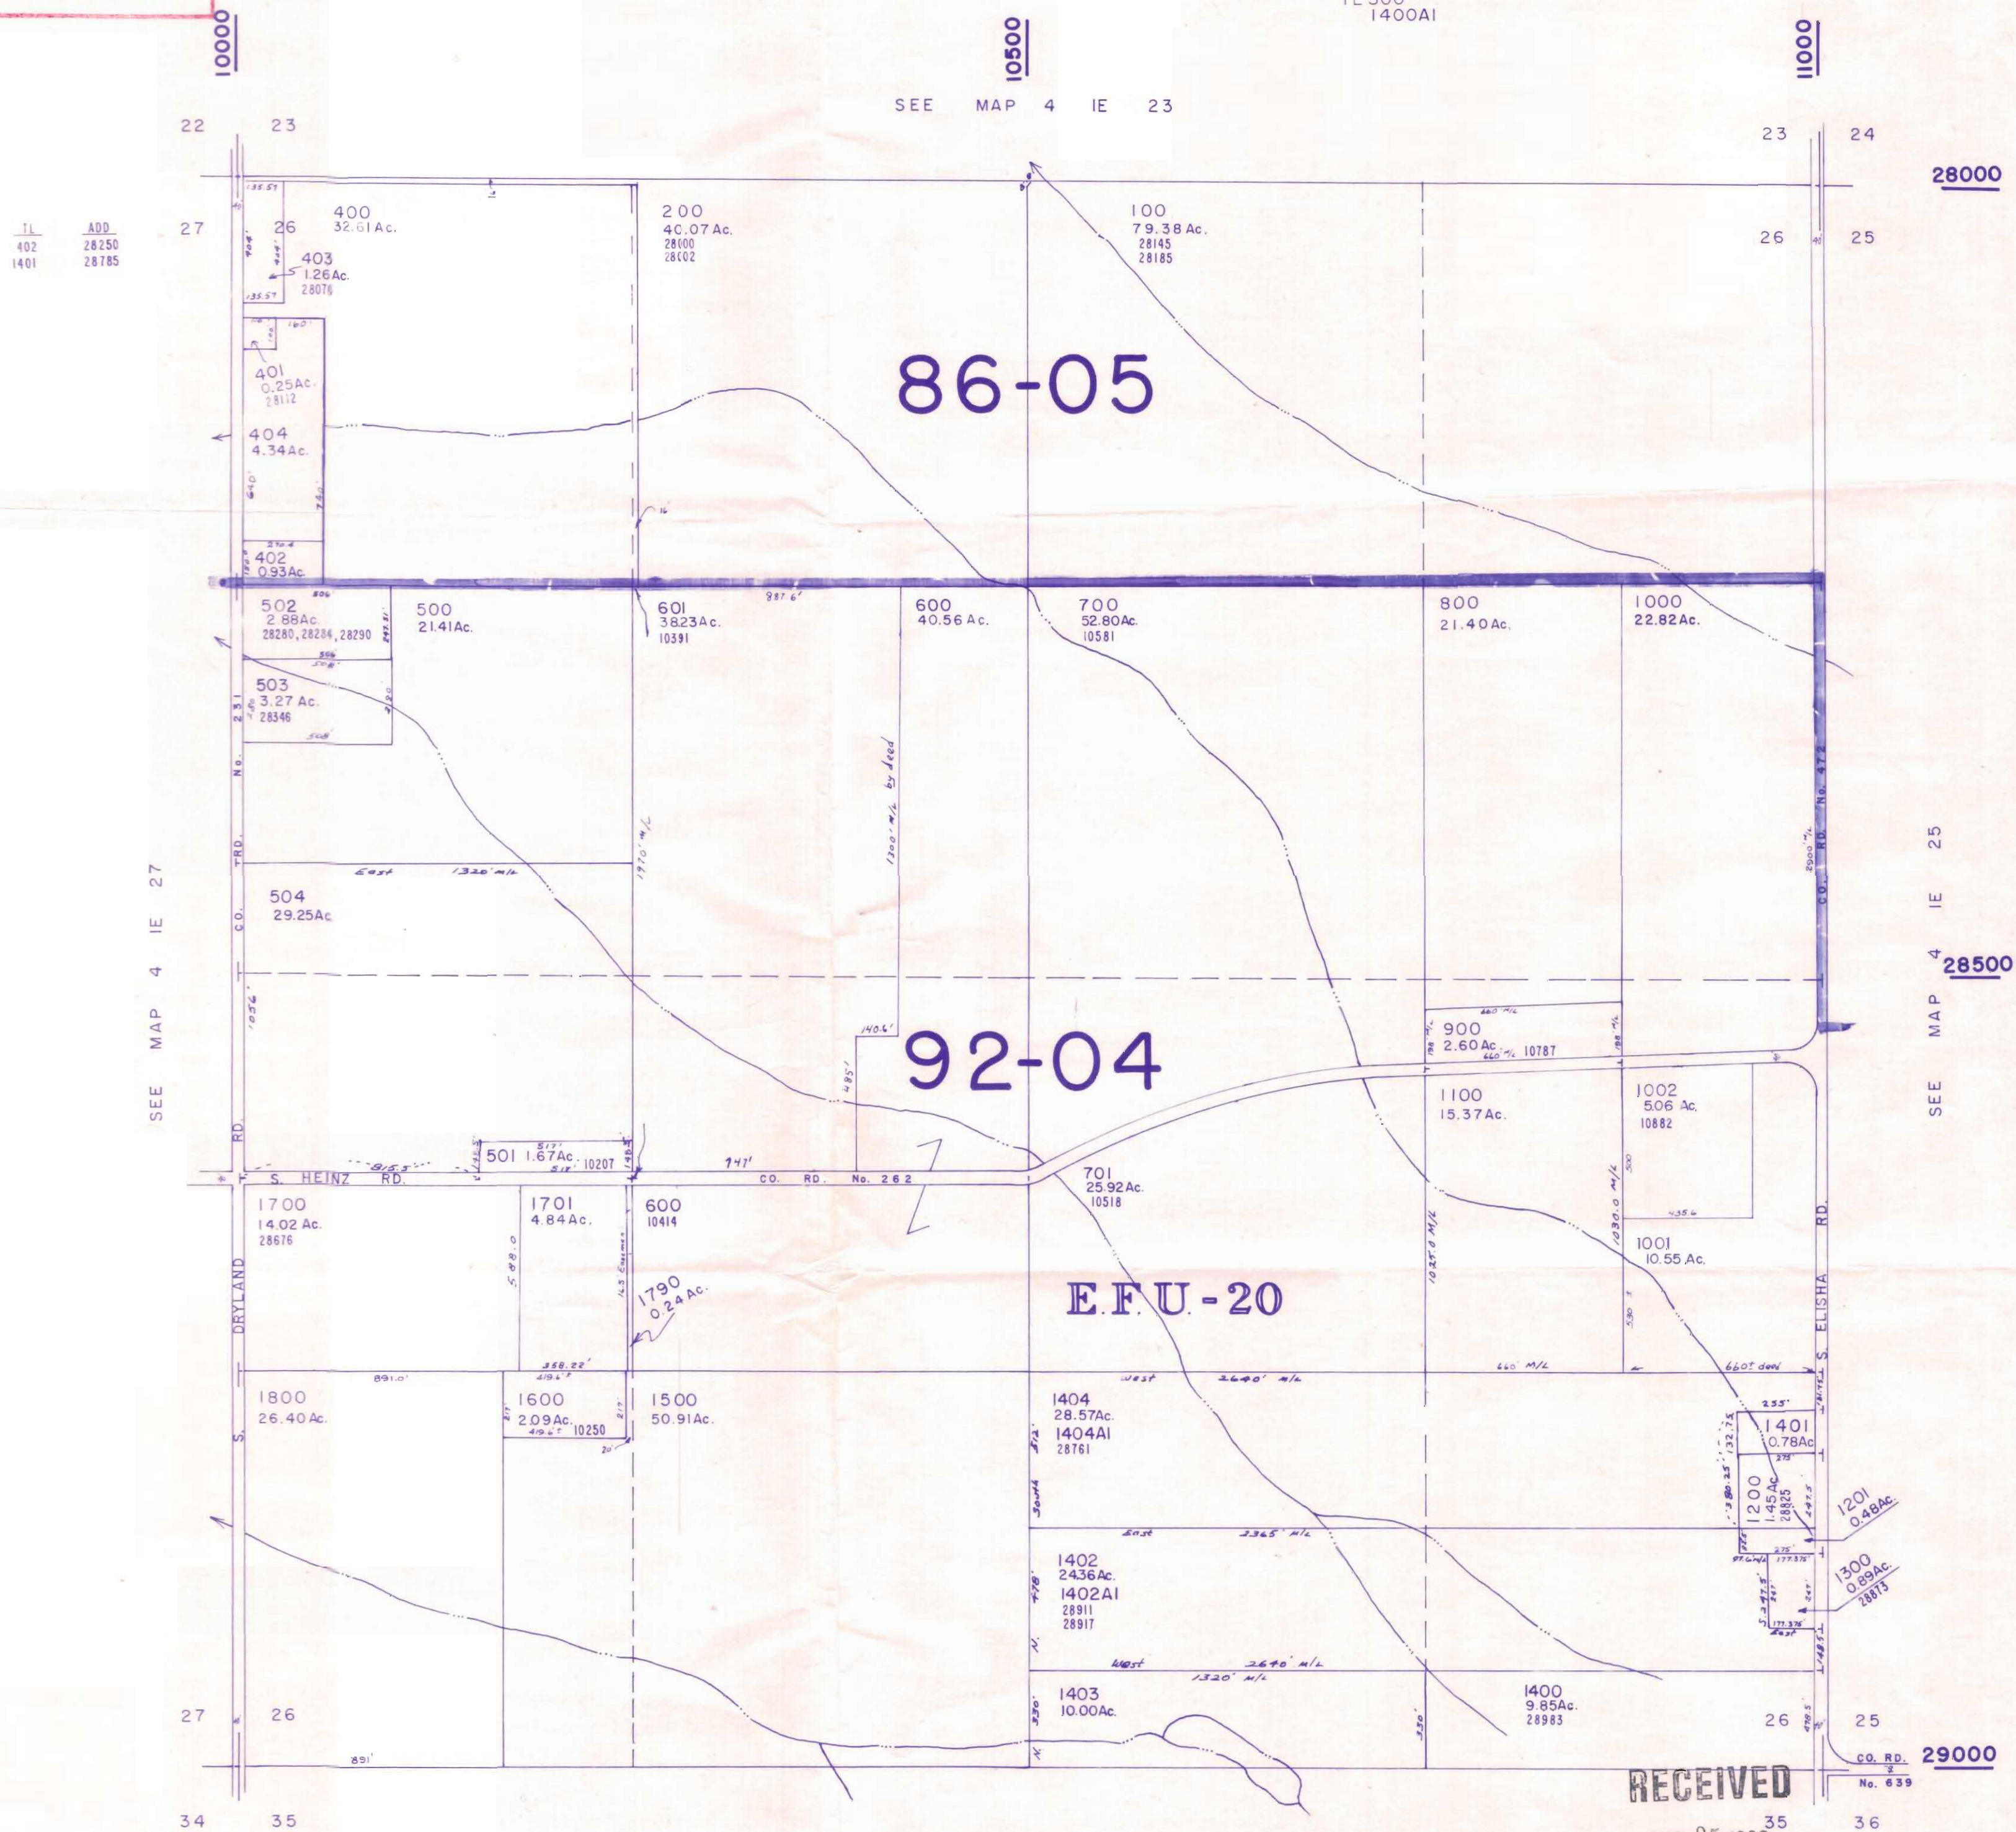

RECEIVED

APR 25 1988

WATER RESOURCES DEPT
SALEM, OREGON

BOOK 35