


SW1/4SW1/4 of Section 12, T.37S., R.6W., W.M.

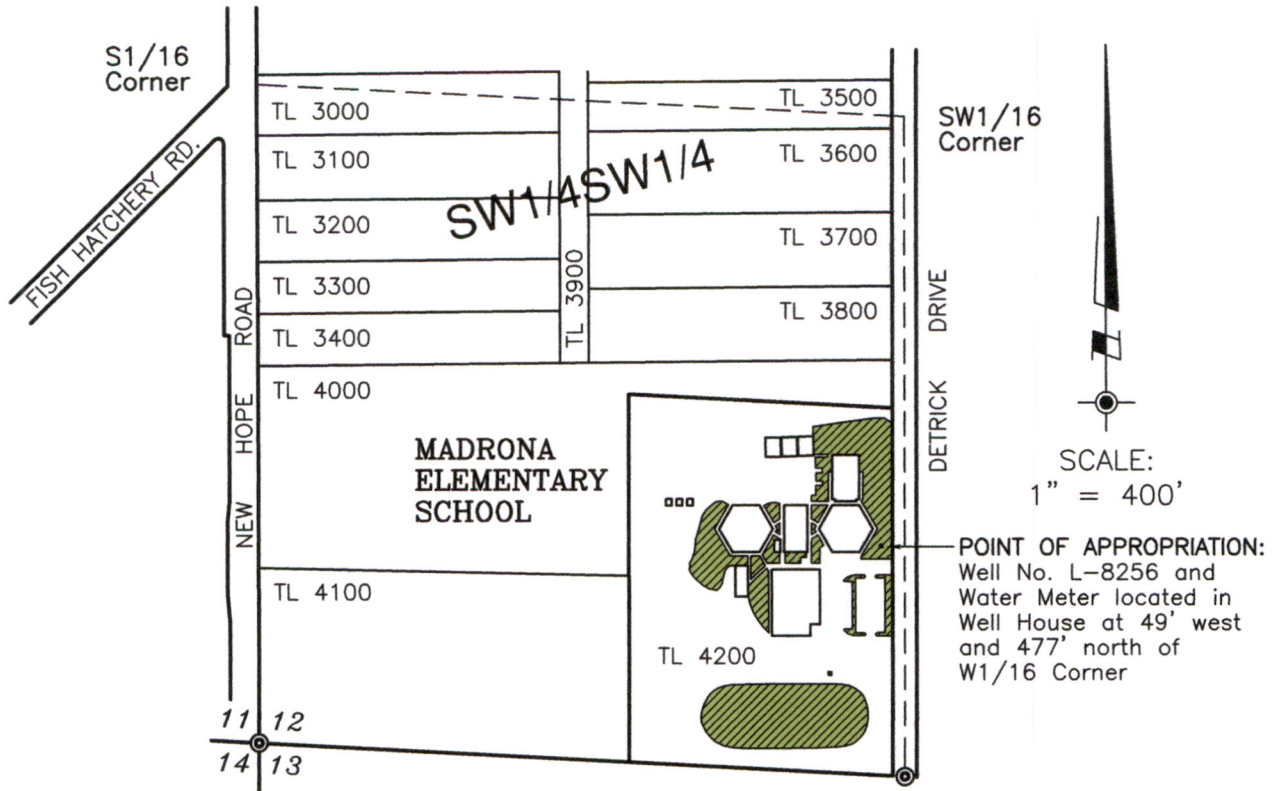

Section Corner  
Fd. Brass Cap  
per C.S. Bk. 7, Pg. 136

SEE DETAIL  
ON SHEET 2

W1/16 Corner  
Fd. 5/8" Iron Rod  
per Survey No. 31-66

This plat was prepared for the purpose of identifying the location of the water right only. There is no intent to provide dimensions or locations of property ownership lines.

This survey was made using a Wild T-1600 Theomat and a Distomat DI-1600 E.D.M.I. with a combined accuracy of 1 second and 3 mm ± 2 ppm.

A twelve page site report accompanies this plat.

Supporting Documents:  
Application No. G-15335  
Permit No. G-15164

Priority Date: March 5, 2001

Usage: Commercial and Irrigation

**LEGEND:**



Place of Use: 2.2 acres

**POINT OF APPROPRIATION:**

Existing Well 49'W and 477'N of  
the W 1/16 Corner of Section 12

RECEIVED

MAR 14 2025

OWRD

madrona (2024).dwg


PROJECT NO.  
1015-06-304

DRAWING NO.  
207-8.5.11

DATE:  
Feb. 29, 2024

SCALE:  
1" = 400'

SHEET NO.  
1 of 2

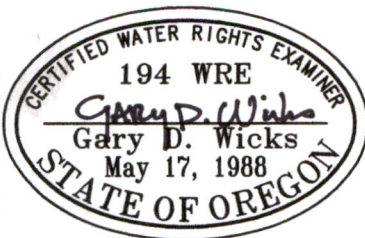

RENEWAL DATE: 6-30-24

**PLAT FOR  
CLAIM OF BENEFICIAL USE**

LOCATED IN:  
SW1/4SW1/4 of Section 12  
Township 37 South, Range 6 West, W.M.  
Josephine County, Oregon


PREPARED FOR:  
THREE RIVERS SCHOOL DISTRICT  
126 Ringuette Street  
Grants Pass, Oregon 97527

Tel: 541-476-6304

PREPARED BY:  
WICKS ENGINEERING & SURVEYING  
311 N.E. "D" Street  
Grants Pass, OR 97526

Tel: 541-479-3436

# DETAIL SHEET MADRONA ELEMENTARY SCHOOL

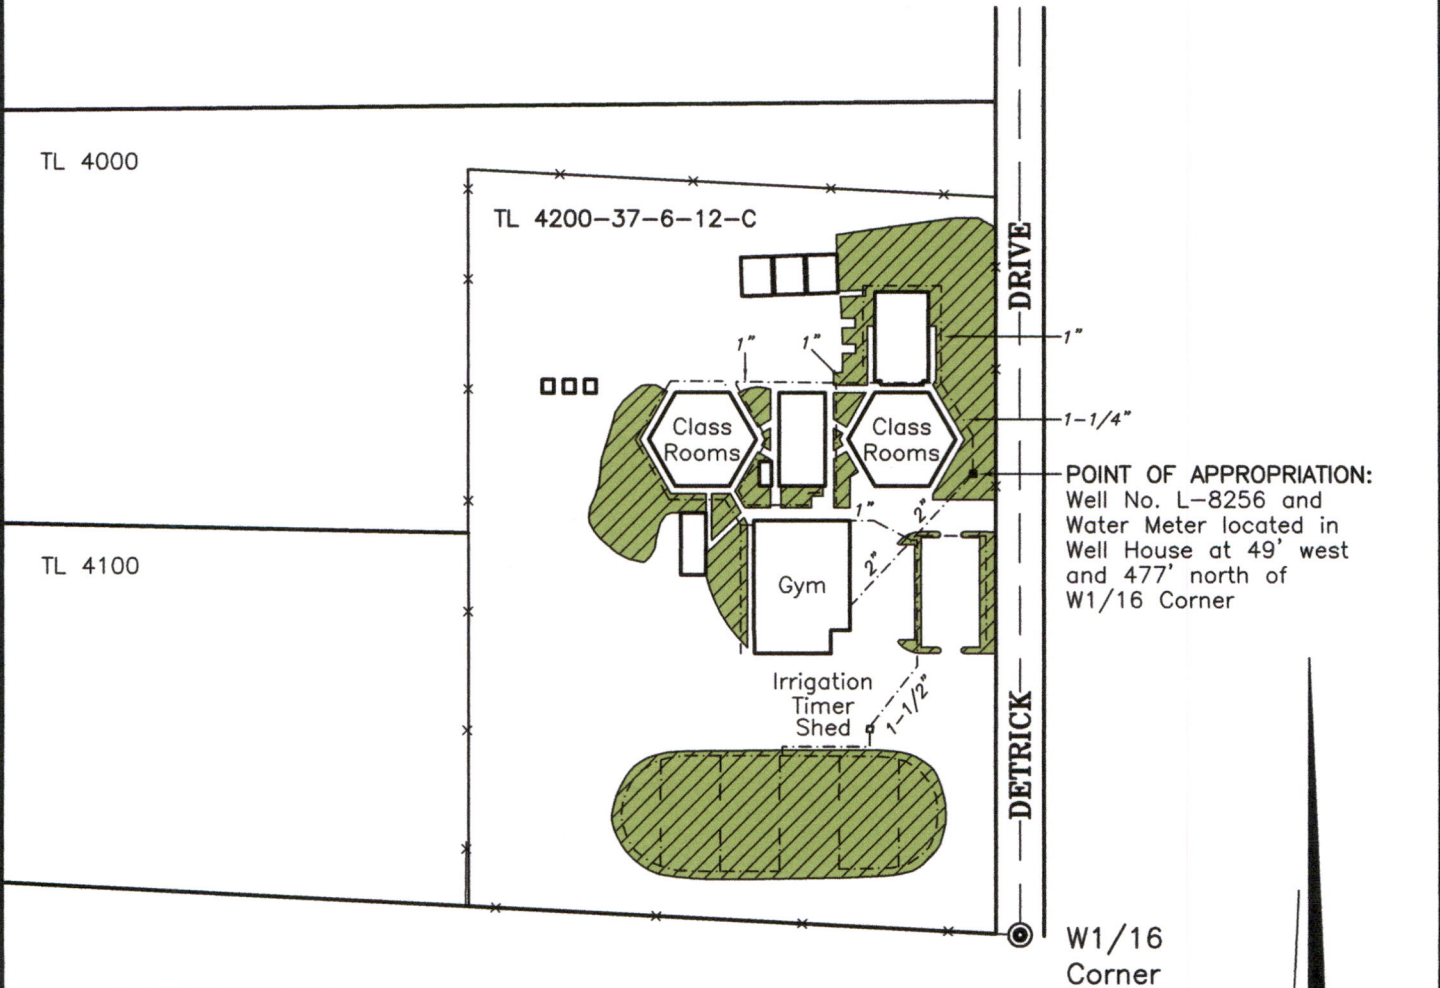

**POINT OF APPROPRIATION:**  
Well No. L-8256 and  
Water Meter located in  
Well House at 49' west  
and 477' north of  
W1/16 Corner

## LEGEND:



Place of Use:  
SW1/4SW1/4 Sec 12: 2.2 Acres



Approximate location of underground  
water line (size as shown)


**RECEIVED**  
**MAR 14 2025**  
**OWRD**



SCALE:  
1" = 200'

madrona (2024).dwg

PROJECT NO. 1015-06-304
DRAWING NO. 208-8.5.11
DATE: Feb. 29, 2024
SCALE: 1" = 200'
SHEET NO. 2 of 2

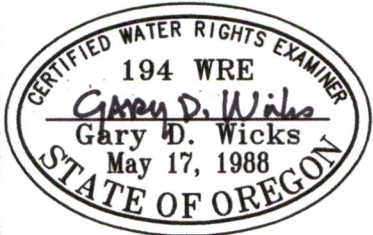

RENEWAL DATE: 6-30-24

**PLAT FOR  
CLAIM OF BENEFICIAL USE**  
LOCATED IN:  
SW1/4SW1/4 of Section 12  
Township 37 South, Range 6 West, W.M.  
Josephine County, Oregon

PREPARED FOR:  
THREE RIVERS SCHOOL DISTRICT  
126 Ringuette Street  
Grants Pass, OR 97527  
Tel: 541-476-6304

PREPARED BY:  
WICKS ENGINEERING & SURVEYING  
311 N.E. "D" Street  
Grants Pass, OR 97526  
Tel: 541-479-3436