

Received by OWRD

MAR 24 2025

Salem, OR

Received

MAR 17 2025

OWRD

Received

FEB 28 2025

OWRD

Received

2025

OWRD

THIS MAP WAS PREPARED FOR
ASSESSMENT PURPOSE ONLY.

SEC.28 T.26S. R.3W. W.M.
DOUGLAS COUNTY
1" = 400'

REVISED ON
2-8-16

26 3 28

SEE MAP 26 3 21

CANCELLED NO'S

SEE MAP 26 3 27

PARCEL 600
1. N21°09'E 136.8'
2. S44°47'30"E 40.02'
3. N12°52'10"E 34.50'
4. N71°11'30"E 59.66'
5. N28°22'40"E 65.36'
6. S60°23'15"E 68.2'
7. N67°20'20"E 83.04'
8. N17°30'E 38.53'
9. N64°15'00"E 202'
10. N21°21'40"E 50.04'
11. N28°18'E 243.89'

595,000

26 3 28

Dwelling 1 is a primary residence

Dwelling 2 is a Barn/shop with a restroom. No one lives in it


#2 = 200' South + 600' W from center of section 28
#3 = 100' north + 100' E from center of section 28
#4 = 250' north + 400' E from center of section 28
#8 = 1980' south + 100' E from center of section 28
--- 3/4 poly pipe existing or proposed

THIS MAP WAS PREPARED FOR
ASSESSMENT PURPOSE ONLY.

SEC.29 T.26S. R.3W. W.M.
DOUGLAS COUNTY
1" = 400'

REVISED ON
1-11-18

26 3 29
& INDEX

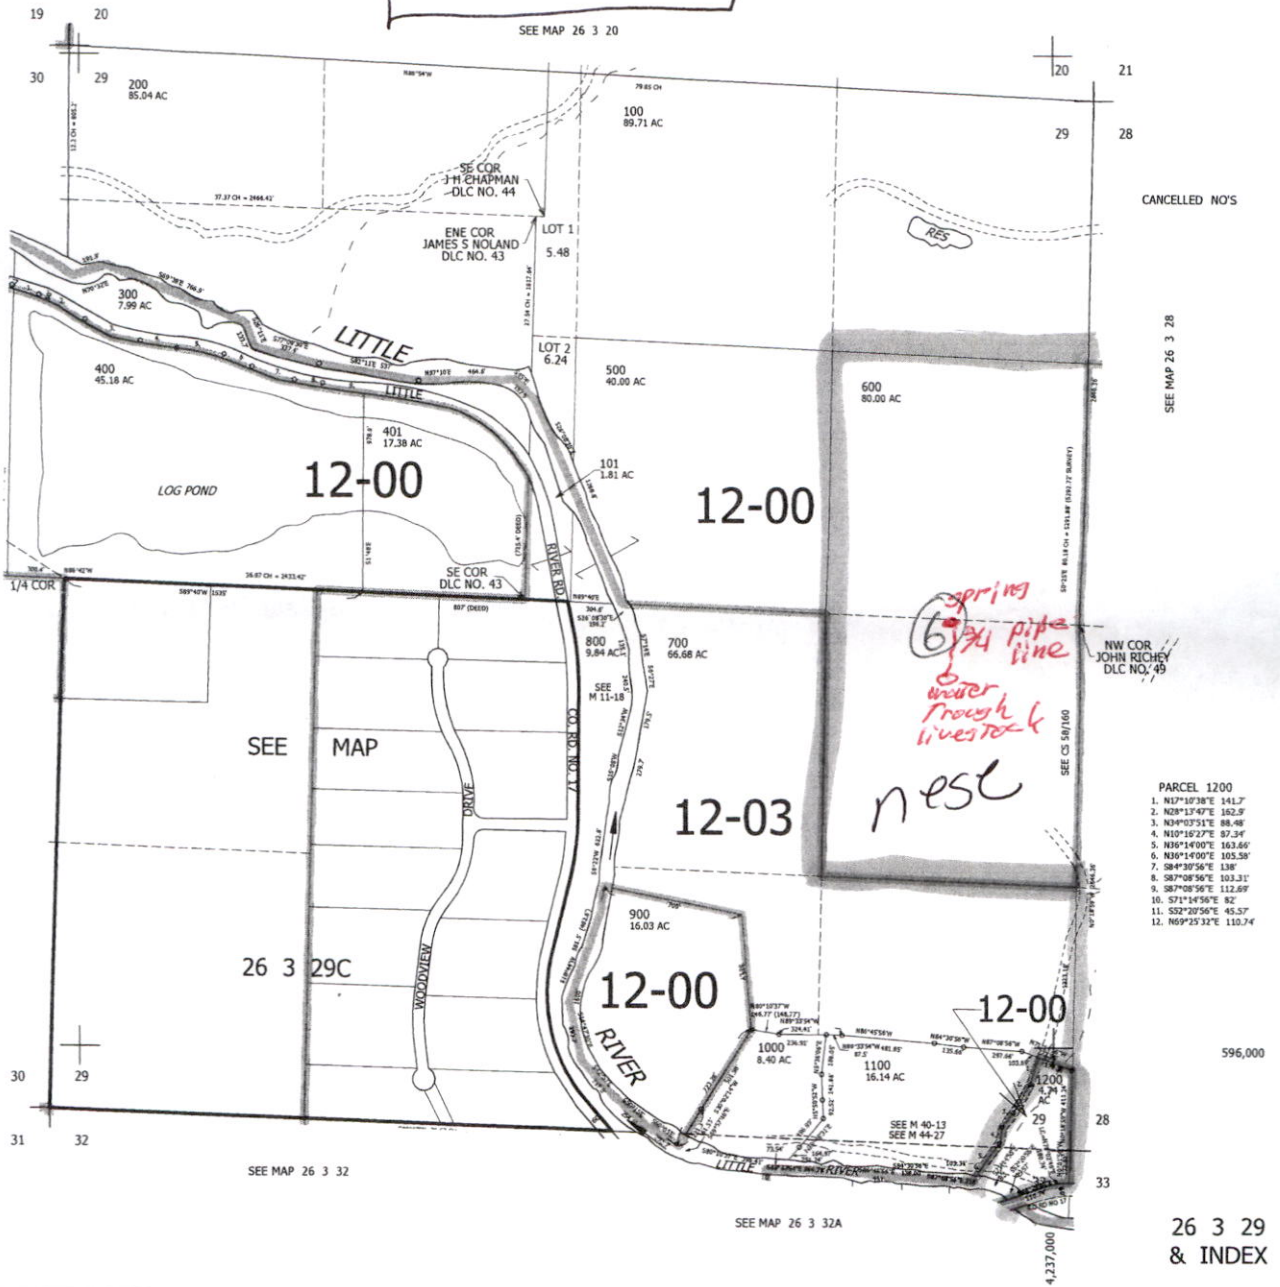

#6 = 150' south + 1200' west from E 1/4 corner
of section 29

Received
FEB 28 2025

OWRD

Received
MAR 17 2025

OWRD