

E-RECEIVED

MAR 31 2025
OWRD

AMENDED 3/27/2025

RECEIVED
FEB 16 2023

OWRD
SALEM, OREGON

OAK PARK FARMS, INC.
GROUNDWATER APPLICATION EXHIBIT MAP

JANUARY 31, 2023

located in
SECTIONS 9, 16, & 17,
IN DLC 53 & 55
TOWNSHIP 12 SOUTH, RANGE 4 WEST,
WILLAMETTE MERIDIAN
LINN COUNTY, OREGON

PROPOSED PLACE OF USE OF PRIMARY IRRIGATED ACRES

AREA A 9.34 ACRES NE 1/4, NW 1/4, SECTION 17 TAX LOT 100	AREA G 29.70 37.88 ACRES NW 1/4, NW 1/4, SECTION 16 TAX LOT 300	AREA M 11.40 ACRES NW 1/4, NE 1/4, SECTION 16 TAX LOT 400
AREA B 0.04 ACRES SE 1/4, NW 1/4, SECTION 17 TAX LOT 100	AREA H 1.80 ACRES SW 1/4, NW 1/4, SECTION 16 TAX LOT 300	AREA N 10.35 ACRES SW 1/4, SE 1/4, SECTION 9 TAX LOT 500
AREA C 30.15 ACRES NW 1/4, NE 1/4, SECTION 17 TAX LOT 100	AREA I 18.64 24.25 ACRES NE 1/4, NW 1/4, SECTION 16 TAX LOT 300	AREA O 5.27 ACRES NW 1/4, NE 1/4, SECTION 16 TAX LOT 500
AREA D 1.37 ACRES SW 1/4, NE 1/4, SECTION 17 TAX LOT 100	AREA J 1.16 ACRES SE 1/4, NW 1/4, SECTION 16 TAX LOT 300	AREA P 30.91 ACRES SE 1/4, SE 1/4, SECTION 9 TAX LOT 500
AREA E 35.87 ACRES NE 1/4, NE 1/4, SECTION 17 TAX LOT 100	AREA K 3.91 ACRES NE 1/4, NW 1/4, SECTION 16 TAX LOT 400	AREA Q 16.52 ACRES NE 1/4, NE 1/4, SECTION 16 TAX LOT 500
AREA F 1.61 ACRES SE 1/4, NE 1/4, SECTION 17 TAX LOT 100	AREA L 13.00 ACRES SW 1/4, SE 1/4, SECTION 9 TAX LOT 400	

TOTAL : 144.79 ACRES

JDMcGee, Inc.

Engineering & Surveying
Land Use Planning
Wastewater Design
"Solving Problems for You"


1215 Main Street
PO Box 1472
Philomath, OR 97370
(541) 929-4226
(541) 929-4227 fax

DRAWN BY: KP
JDM PROJECT #: 18-41B

CHECKED BY: JDM
DATE: 11/02/2021



RENEWS: 12/31/2024

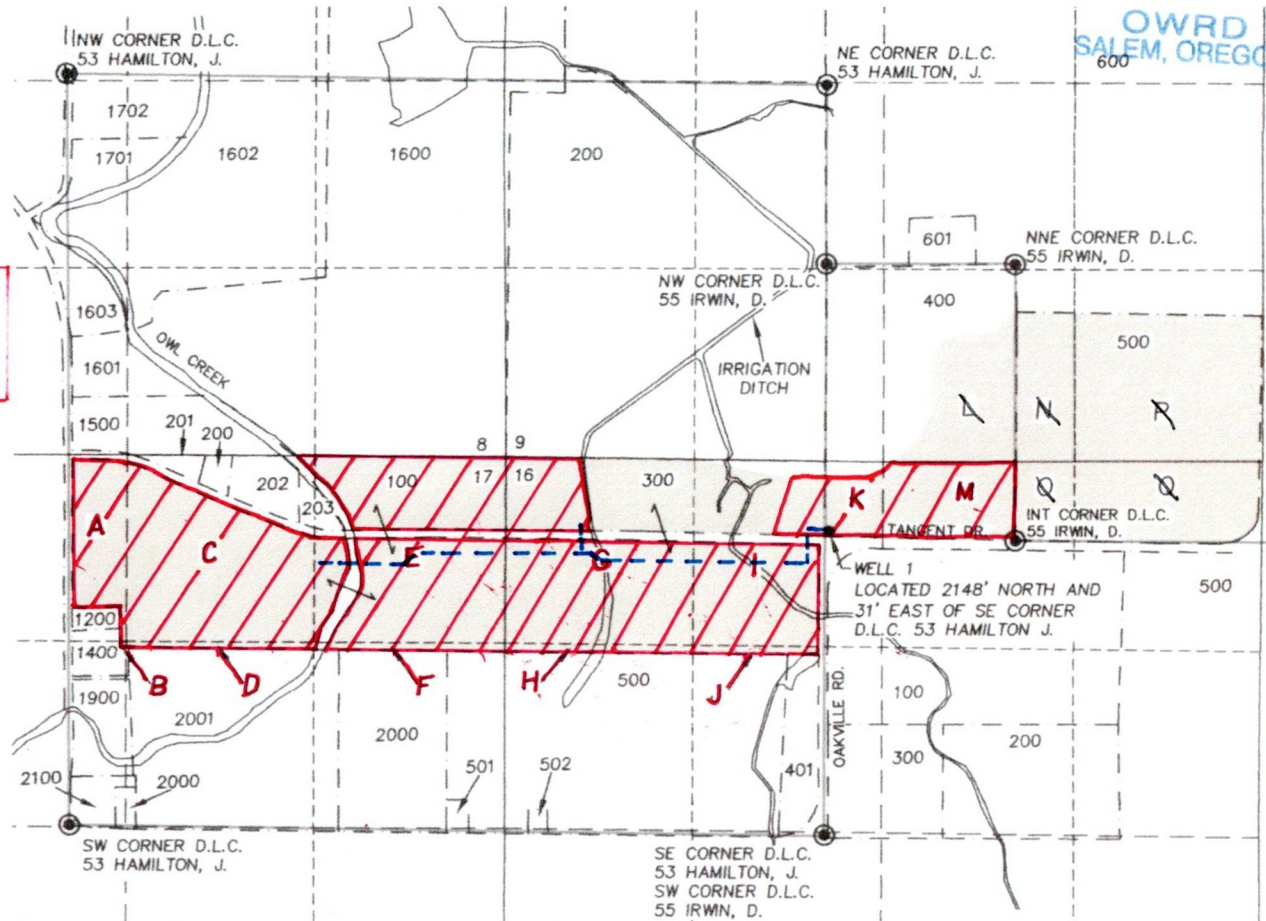

SCALE: 1" = 1320'



LEGEND

- WATERWAYS
- SECTION LINE
- QTR-SECTION LINE
- QTR-QTR-SECTION LINE
- TAX LOT LINE
- D.L.C. LINE
- D.L.C. CORNER, AS NOTED
- POINT OF APPROPRIATION
- PROPOSED PLACE OF USE