
Marion County

Township 4 South, Range 1 West from the Willamette Meridian

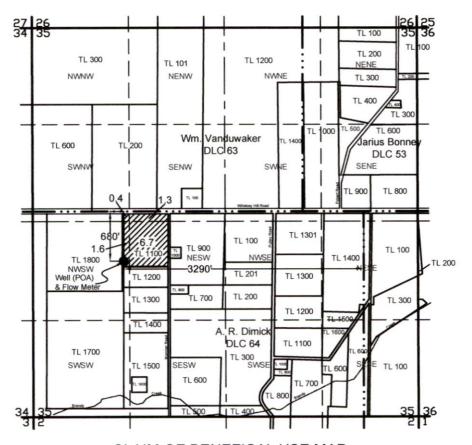

CLAIM OF BENEFICAL USE MAP

FOR Transfer T-11852 in the name of

Fiofil Kartal

Well (POA) is 680 Feet South and 3,290 Feet West from the Northeast corner of DLC 64.



Received by OWRD

MAR 31 2025

Salem, OR

Map Legend

— — - Quarter Quarter Section Line

- Half Section Line
- Section Line

- Tax Lot Boundary Line
- DLC Boundary Line

- Area irrigated from Well (POA)

Certified Water Right Examiner

255WRE

Bruce D. Wilson
May 22, 1990

ATE OF OREGON

Expires: 06/30/2026

NOTE: THIS MAP WAS PREPARED FOR THE PURPOSE OF IDENTIFYING THE LOCATION OF A WATER RIGHT ONLY AND IS NOT INTENDED TO PROVIDE LEGAL DIMENSIONS OR LOCATION OF PROPERTY OWNERSHIP LINES.