


FINAL PROOF MAP T-7267
 SE1/4SW1/4 AND SW1/4SW1/4, SECTION 15
 T.35S., R.4W., W.M.
 JACKSON COUNTY, OREGON
 FOR
 LYLE A. AND LISA A. HENRICKS
 10612 EAST EVANS CREEK ROAD
 ROGUE RIVER, OREGON 97537

T.35S., R.4W.

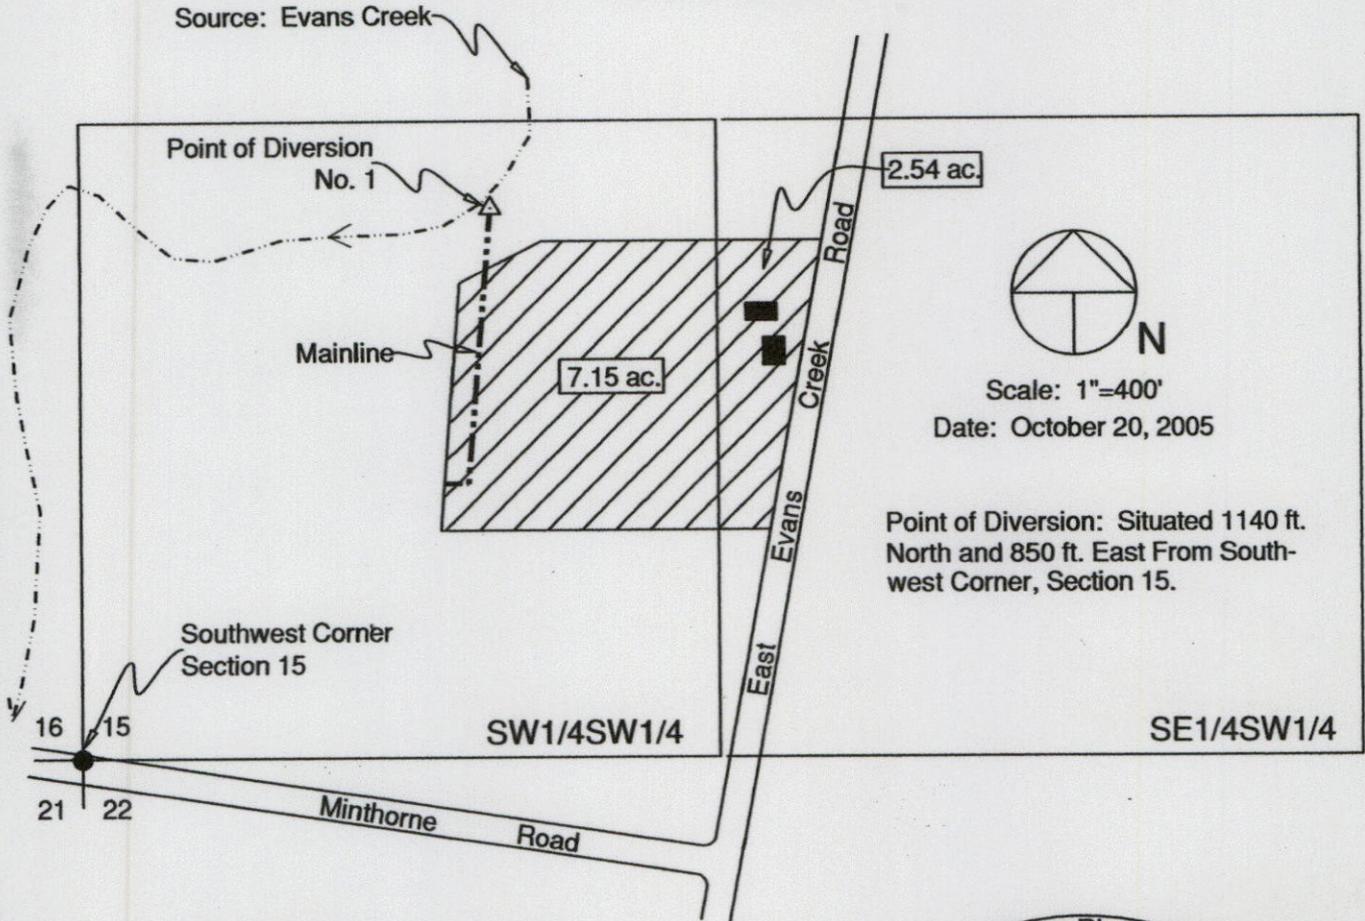

LEGEND

- Found Survey Monument
- Denotes Building
- - - Denotes Mainline Pipe
- ▨ Denotes Area Under Special Order Volume 50 Pages 62 to 64

This map was prepared for the purpose of identifying the location of a water right only and is not intended to provide legal dimensions or location of property ownership.

RECEIVED

OCT 31 2005

WATER RESOURCES DEPT
 SALEM, OREGON



HAROLD L. CENTER
 2604 David Lane
 Medford, OR. 97504
 Phone 541-535-6108
 Oregon Certificate No. 152
 Certificate Renewal Date: 12/31/2005