
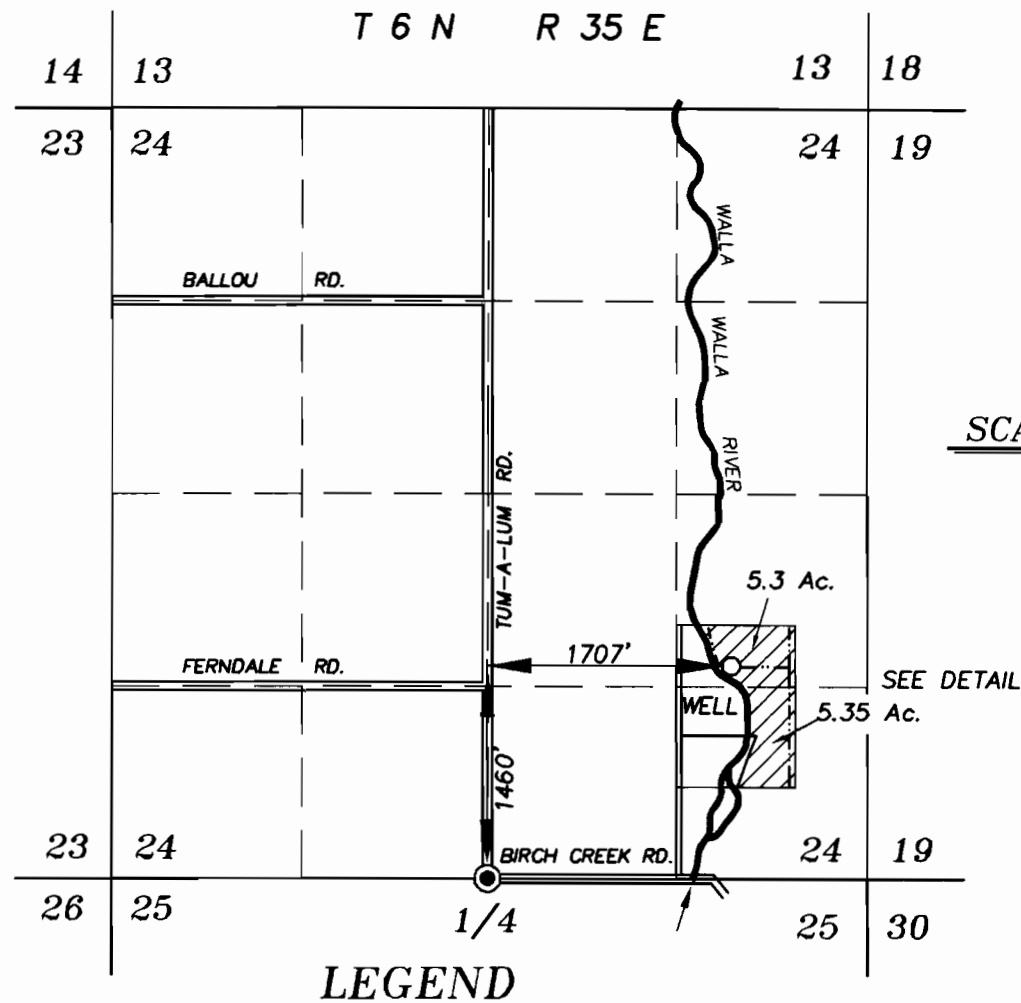


Lands being irrigated by Permit number G-11931.

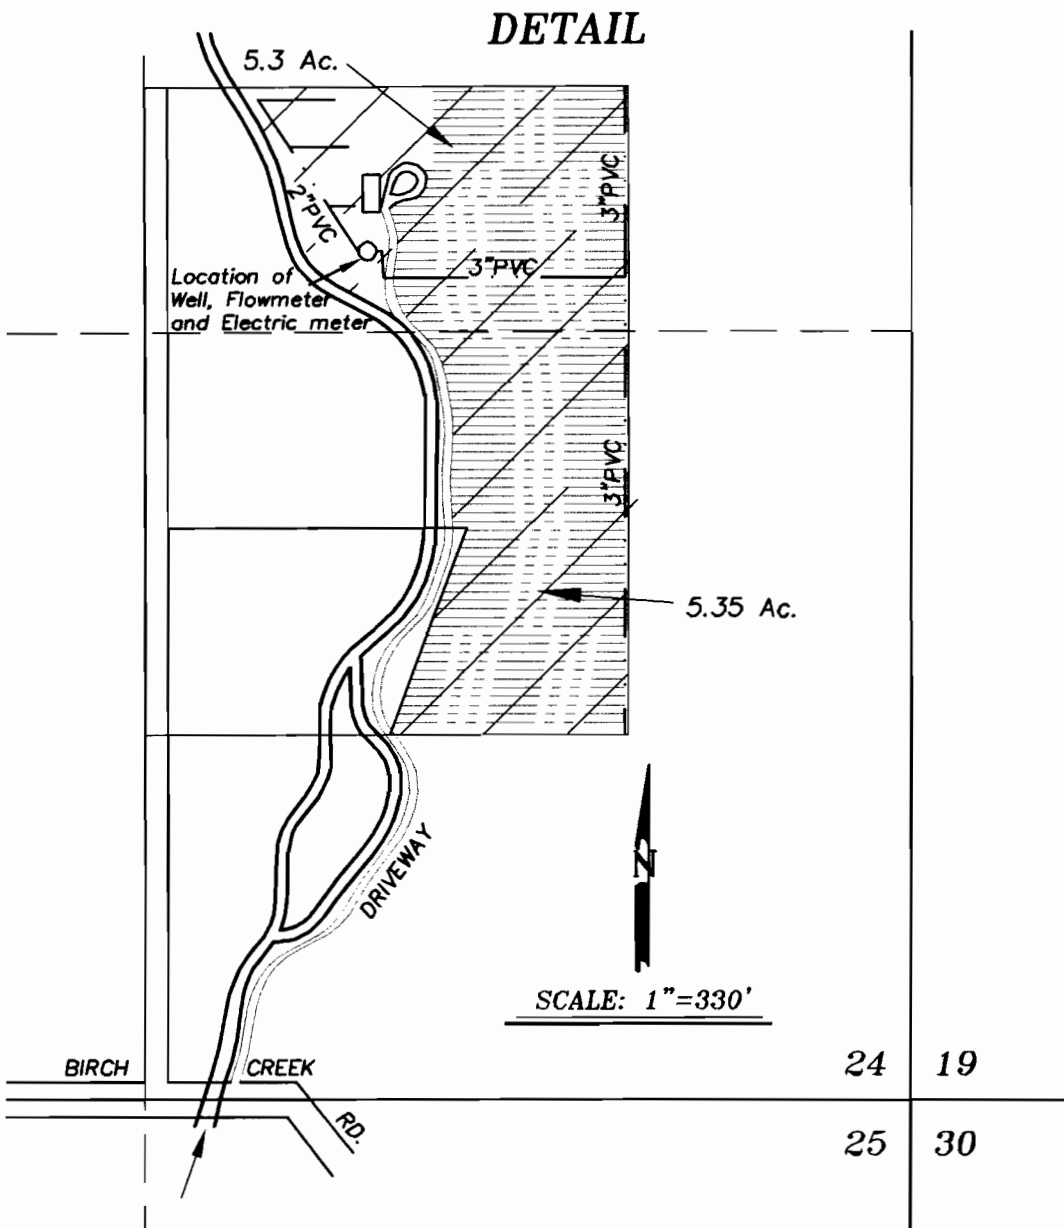

Low pressure irrigation lines.

RECEIVED

6 2007


WATER RESOURCES DEPT
SALEM, OREGON

RECEIVED

JUN 06 2007

WATER RESOURCES DEPT
SALEM, OREGON

SCALE: 1"=1320'

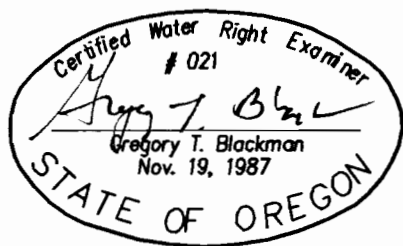

NOTE: The preparation of this map was for the purpose of identifying the location of the proposed water right and has no intent to provide dimensions or location of property ownership lines. Location information shown hereon was furnished by the applicant.

COBU MAP # 0270

May 17, 2007

**FINAL PROOF MAP OF
WATER RIGHTS FROM A WELL**

FOR

WALTER JOSEPH HUMBERT

BY

BAGETT - GRIFFITH & BLACKMAN
2006 ADAMS AVENUE
LAGRANDE, OREGON 97850

APPLICATION NO. G-12923

PERMIT NUMBER G-11931