

Claim of Beneficial Use - Place of Use Map

Transfer T-13525 (former Certificate 95662)

A Water Right in the Name of Farmland Reserve, Inc.

Morrow County

Township 4 North, Range 26 East (W.M.)



LEGEND


- Place of Use (30.58 acres)
- Tax Lots
- Roads
- Railroads
- Watercourses
- Pipelines




Scale
0 660 1,320 ft
1-inch = 1,320 feet

Date: 11/6/2024
Data Sources: BLM,OGIC, ESRI, USGS, Morrow Co.
Disclaimer: This map was prepared for the purpose of identifying the location of a water right only and is not intended to provide legal dimensions or location of property ownership lines.

Received
APR 04 2025
OWRD


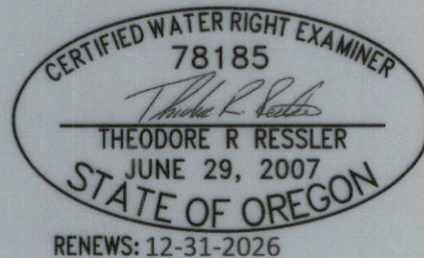


Agri Northwest

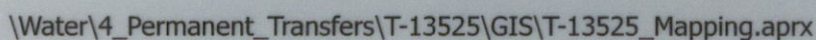


Claim of Beneficial Use - Place of Use Map Transfer T-13525 (former Certificate 92993)

A Water Right in the Name of Farmland Reserve, Inc.
Umatilla County
Township 3 North, Range 28 East (W.M.)

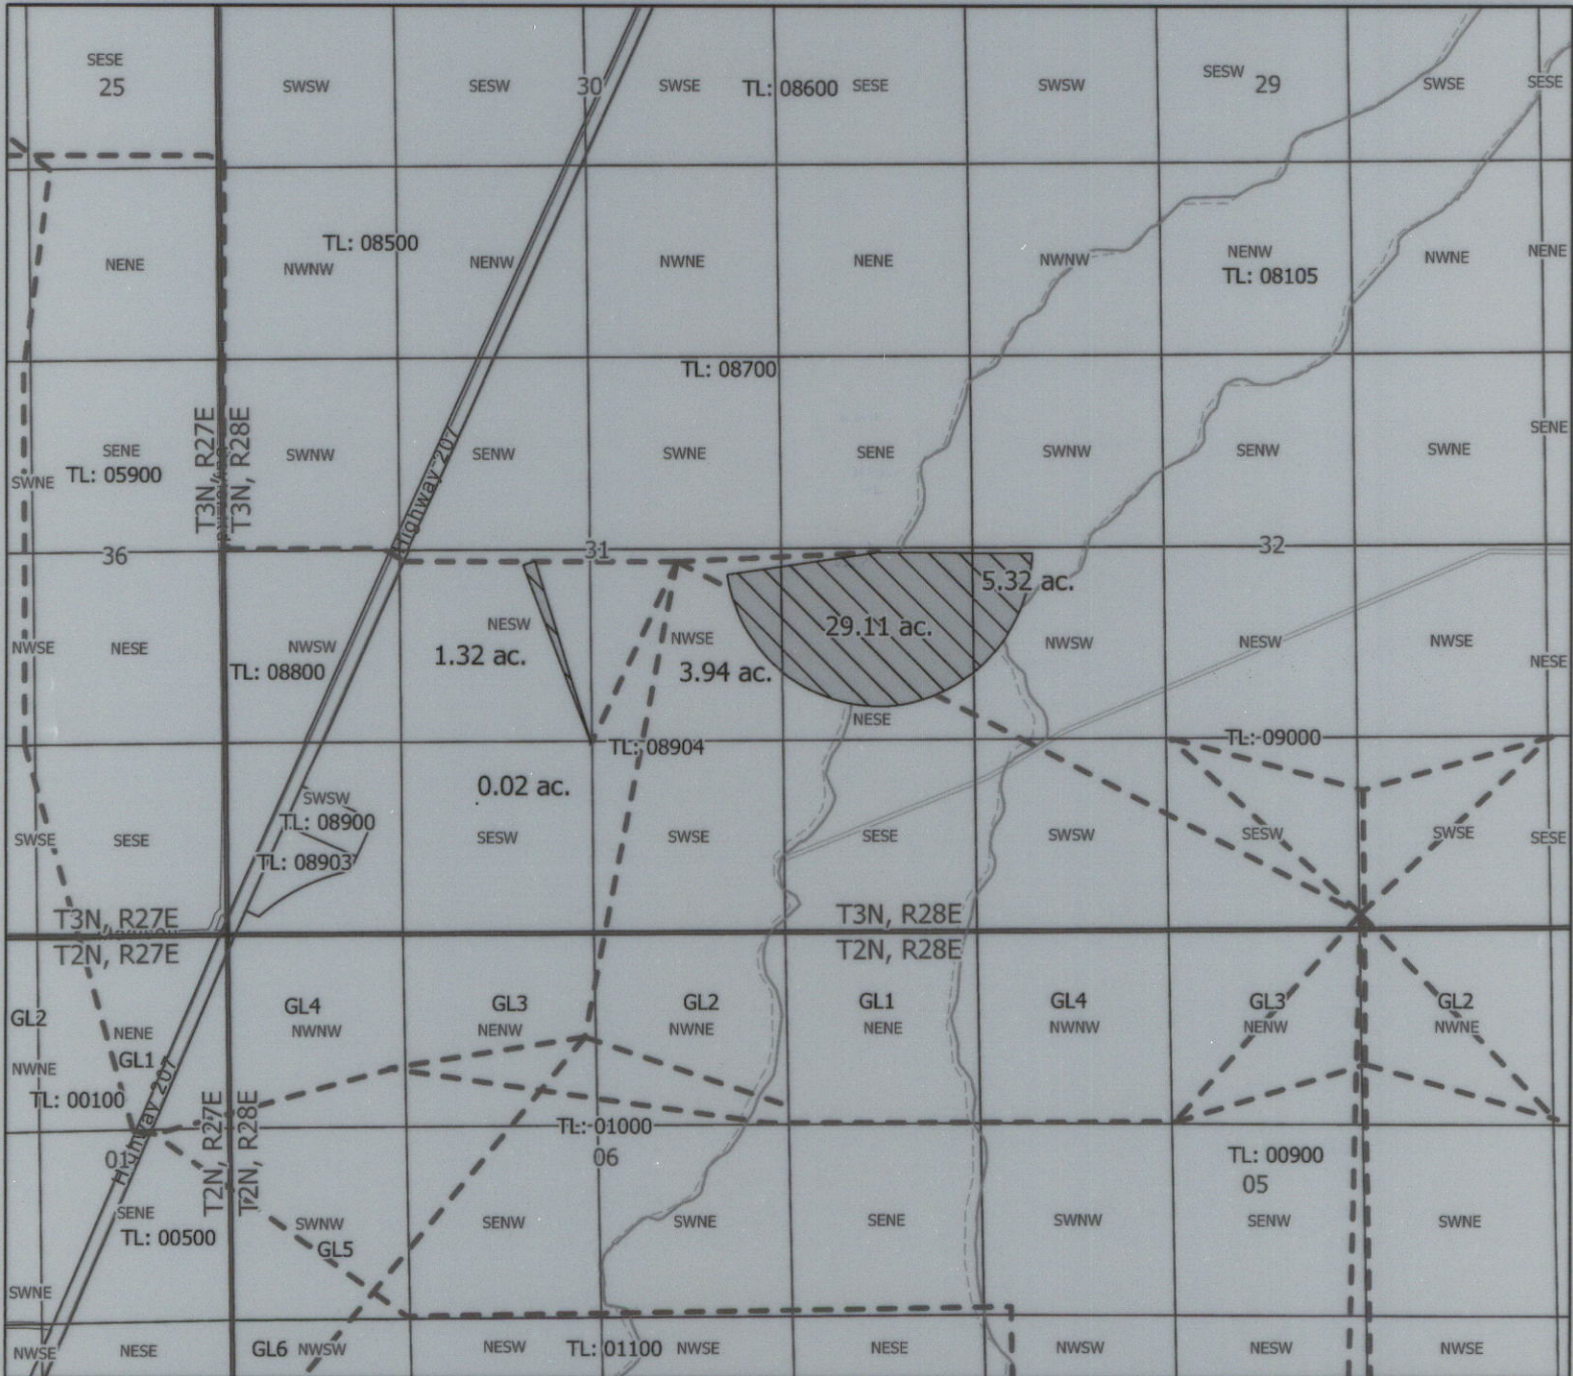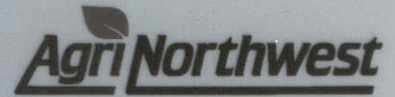

Legend

- Place of Use (39.71 acres)
- Pipeline
- Watercourse
- Tax Lot
- Government Lot (GL)

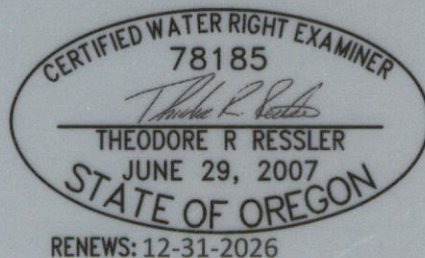

DISCLAIMER

This map was prepared for the purpose of identifying the location of a water right only and it is not intended to provide legal dimensions or location of property ownership lines.

MAP NOTES

Data Sources: BLM, ODFW, OGIC, ESRI, USGS, Umatilla Co.
Current as of: 11/7/2024



Received
APR 04 2025
OWRD



0 670 1,340 Feet
1" = 1,320 feet

Claim of Beneficial Use - Point of Diversion Map 1
Transfer T-13525 (former Cert.'s 92990, 92992, 92993, 92994, and 95622)

Water Rights in the Name of Farmland Reserve, Inc.
Morrow County
Township 4 North, Range 25 East (W.M.)

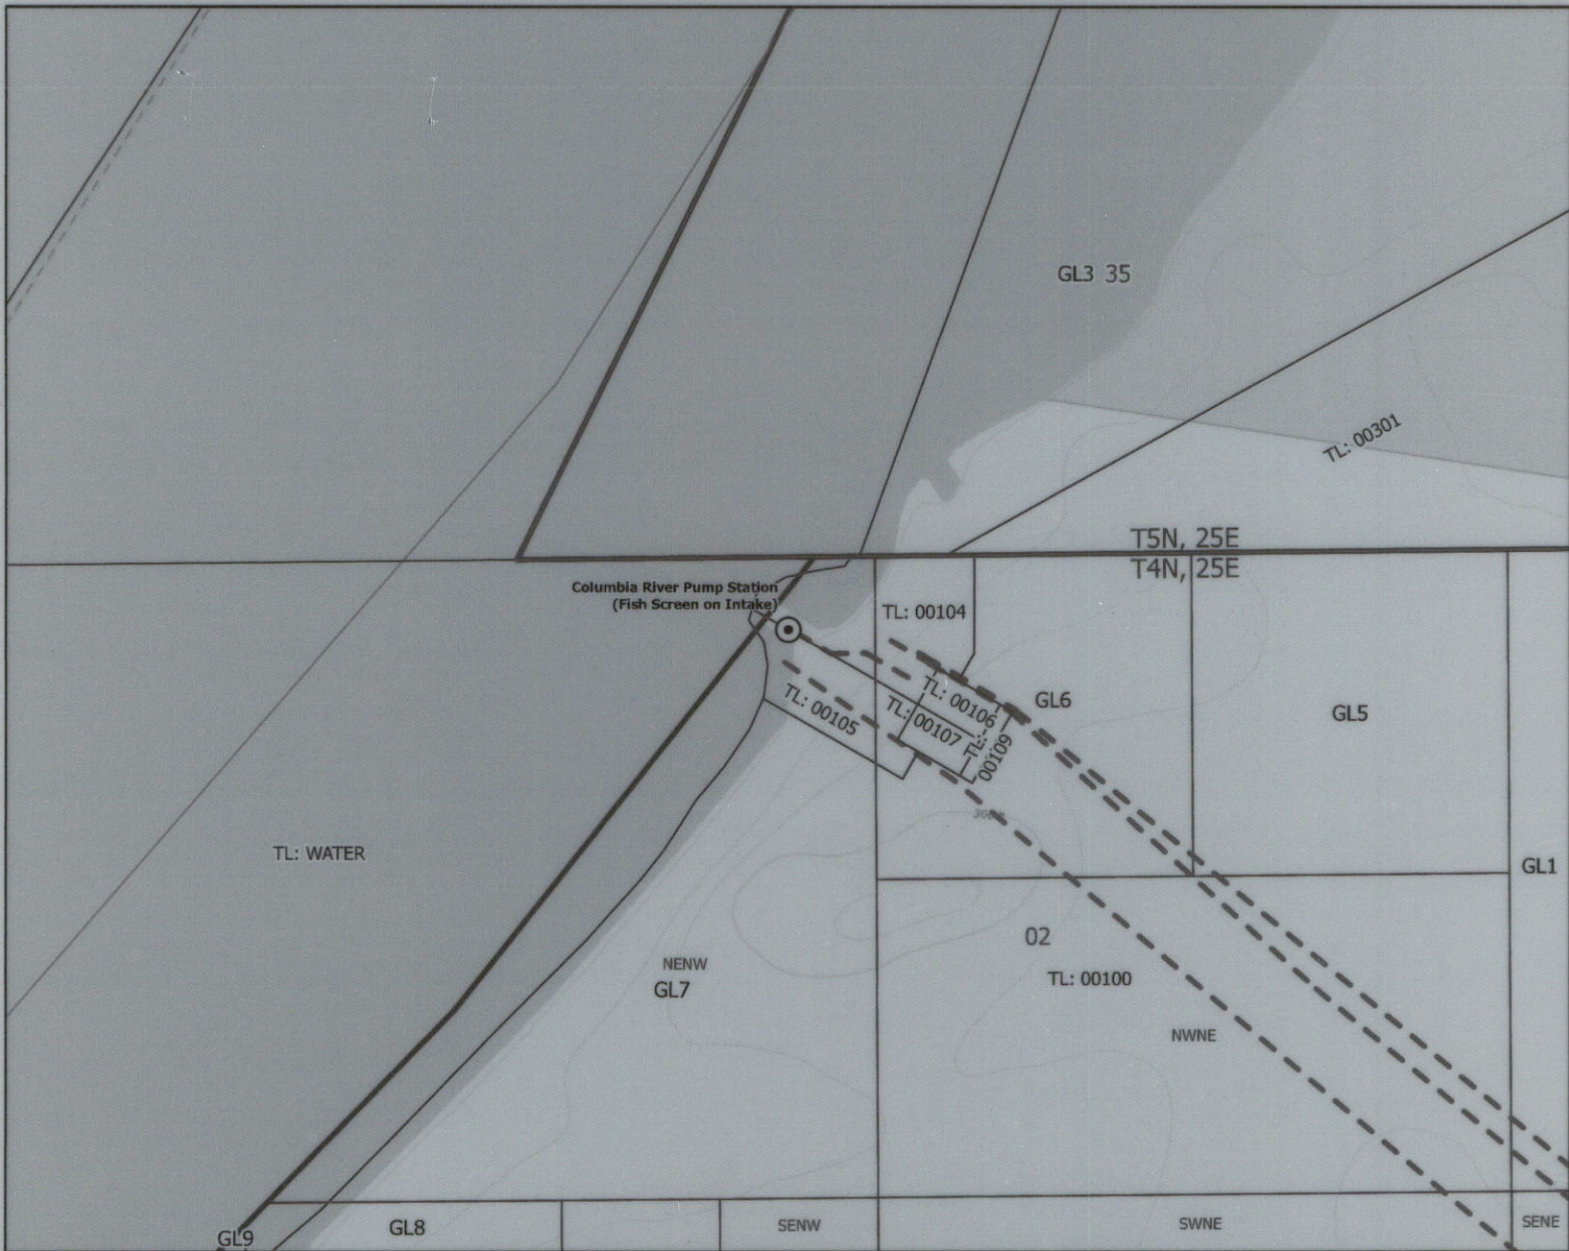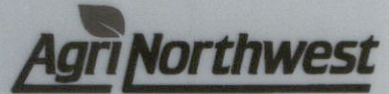

Legend

- Point of Diversion (POD)
- Government Lot (GL)
- - Pipeline
- ~ Watercourse
- Tax Lot

POD Location Description

Columbia River Pump Station
Located South 86 degrees 22 minutes 46 seconds West,
2,829 feet from the NE corner of Section 2, Township 4 North,
Range 25 East (W.M.)


DISCLAIMER

This map was prepared for the purpose of identifying the location of a water right only and it is not intended to provide legal dimensions or location of property ownership lines.

MAP NOTES

Data Sources: BLM, ODFW,
OGIC, ESRI, USGS, Morrow and Umatilla Co.'s

Current as of: 11/27/2024

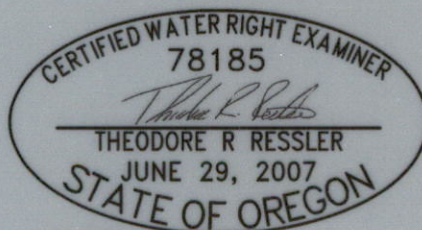

RENEWS: 12-31-2026



Received
APR 04 2025
OWRD



0 200 400 Feet
1" = 400 feet

Claim of Beneficial Use - Point of Diversion Map 2 Transfer T-13525 (former Certificate 93872)

A Water Right in the Name of Farmland Reserve, Inc.
Umatilla County
Township 5 North, Range 30 East (W.M.)

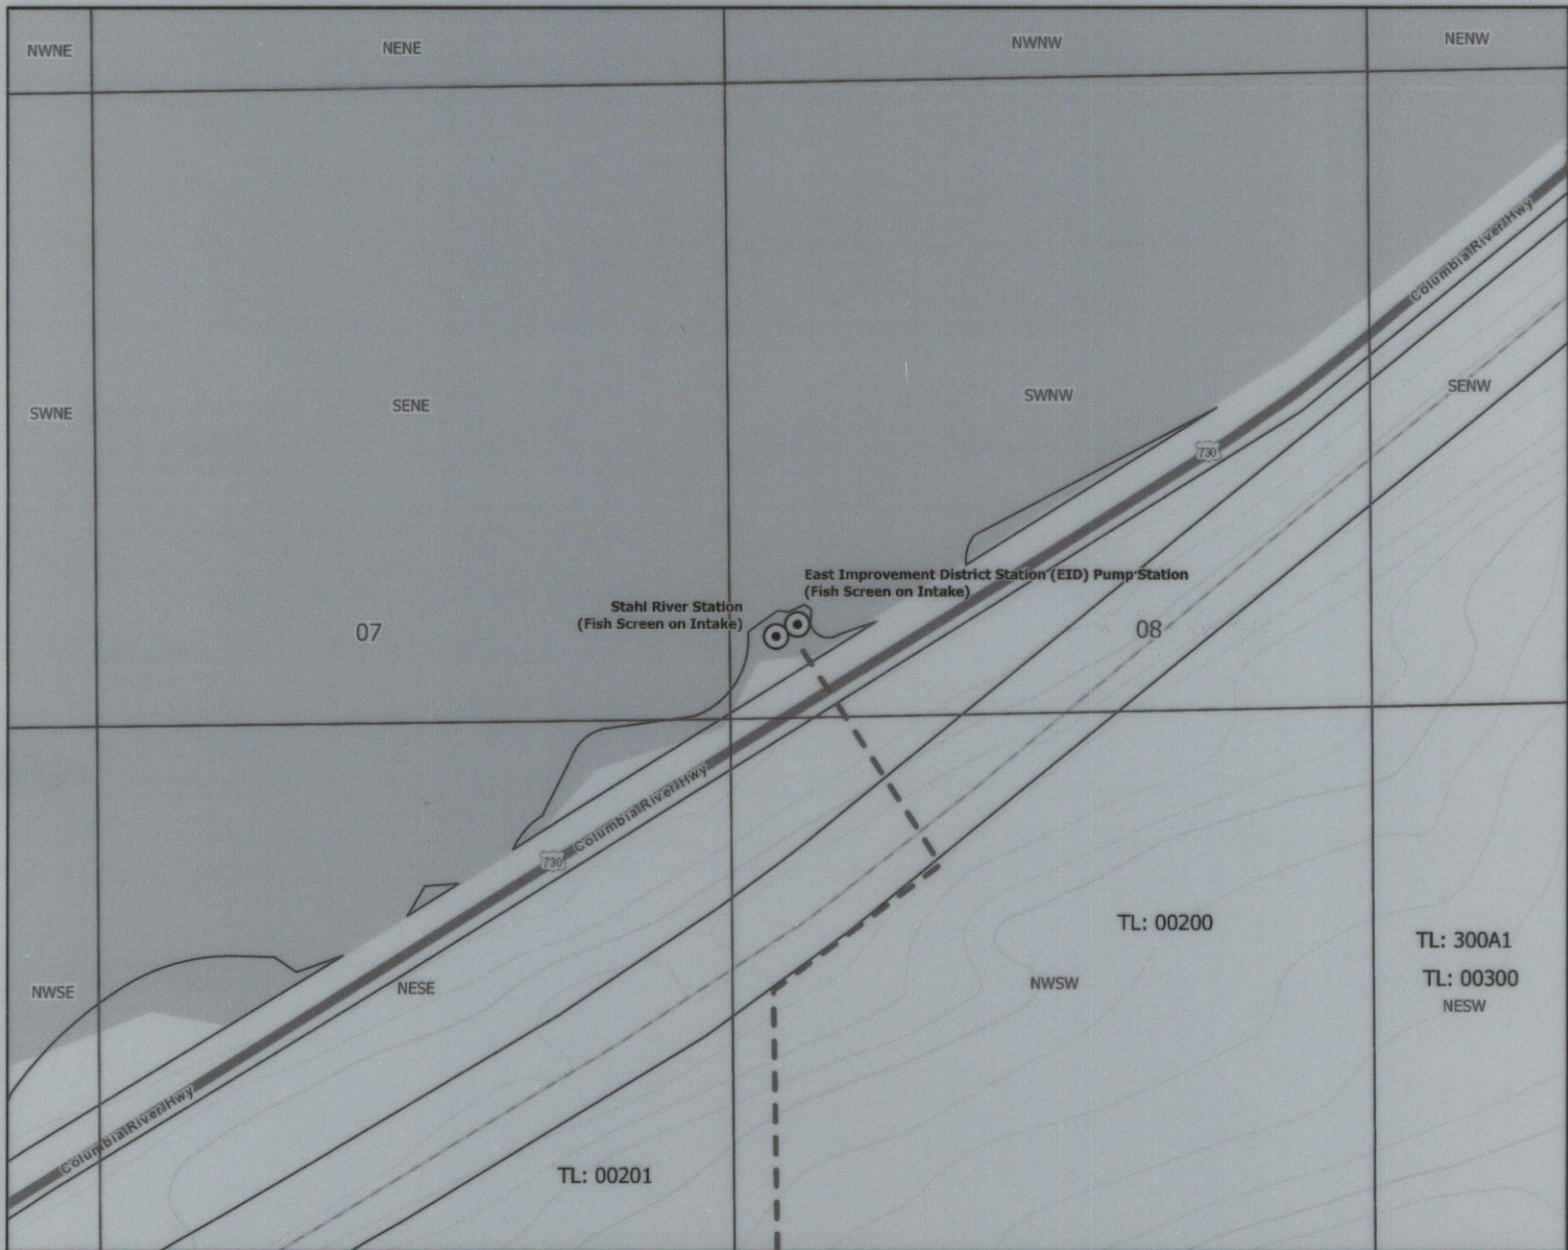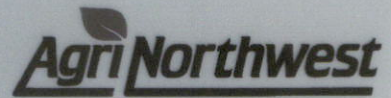


Legend

- ⊙ Point of Diversion (POD)
- Government Lot (GL)
- - Pipeline
- ~ Watercourse
- Tax Lot

POD Location Description

Stahl Pump Station: Located 2860 feet North and 70 feet East from the SW corner of Section 8, Township 5 North, Range 30 East (W.M.)

East Improvement District (EID) Pump Station: Located 2910 feet North and 120 feet East from the SW corner of Section 8, Township 5 North, Range 30 East (W.M.)

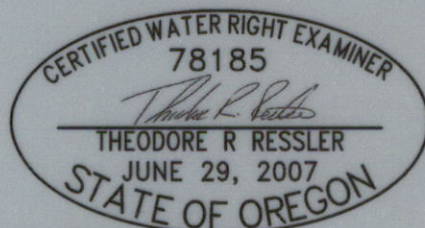

RENEWALS: 12-31-2026

DISCLAIMER

This map was prepared for the purpose of identifying the location of a water right only and it is not intended to provide legal dimensions or location of property ownership lines.

MAP NOTES

Data Sources: BLM, ODFW, OGIC, ESRI, USGS, Morrow and Umatilla Co.'s

Current as of: 11/27/2024

Received

APR 04 2025


OWRD



0 200 400 Feet
1" = 400 feet


Claim of Beneficial Use - Place of use Map
Transfer T-13525 (former Certificate 92992)

A Water Right in the Name of Farmland Reserve, Inc.
Umatilla County
Township 2 and 3 North, Range 28 East (W.M.)

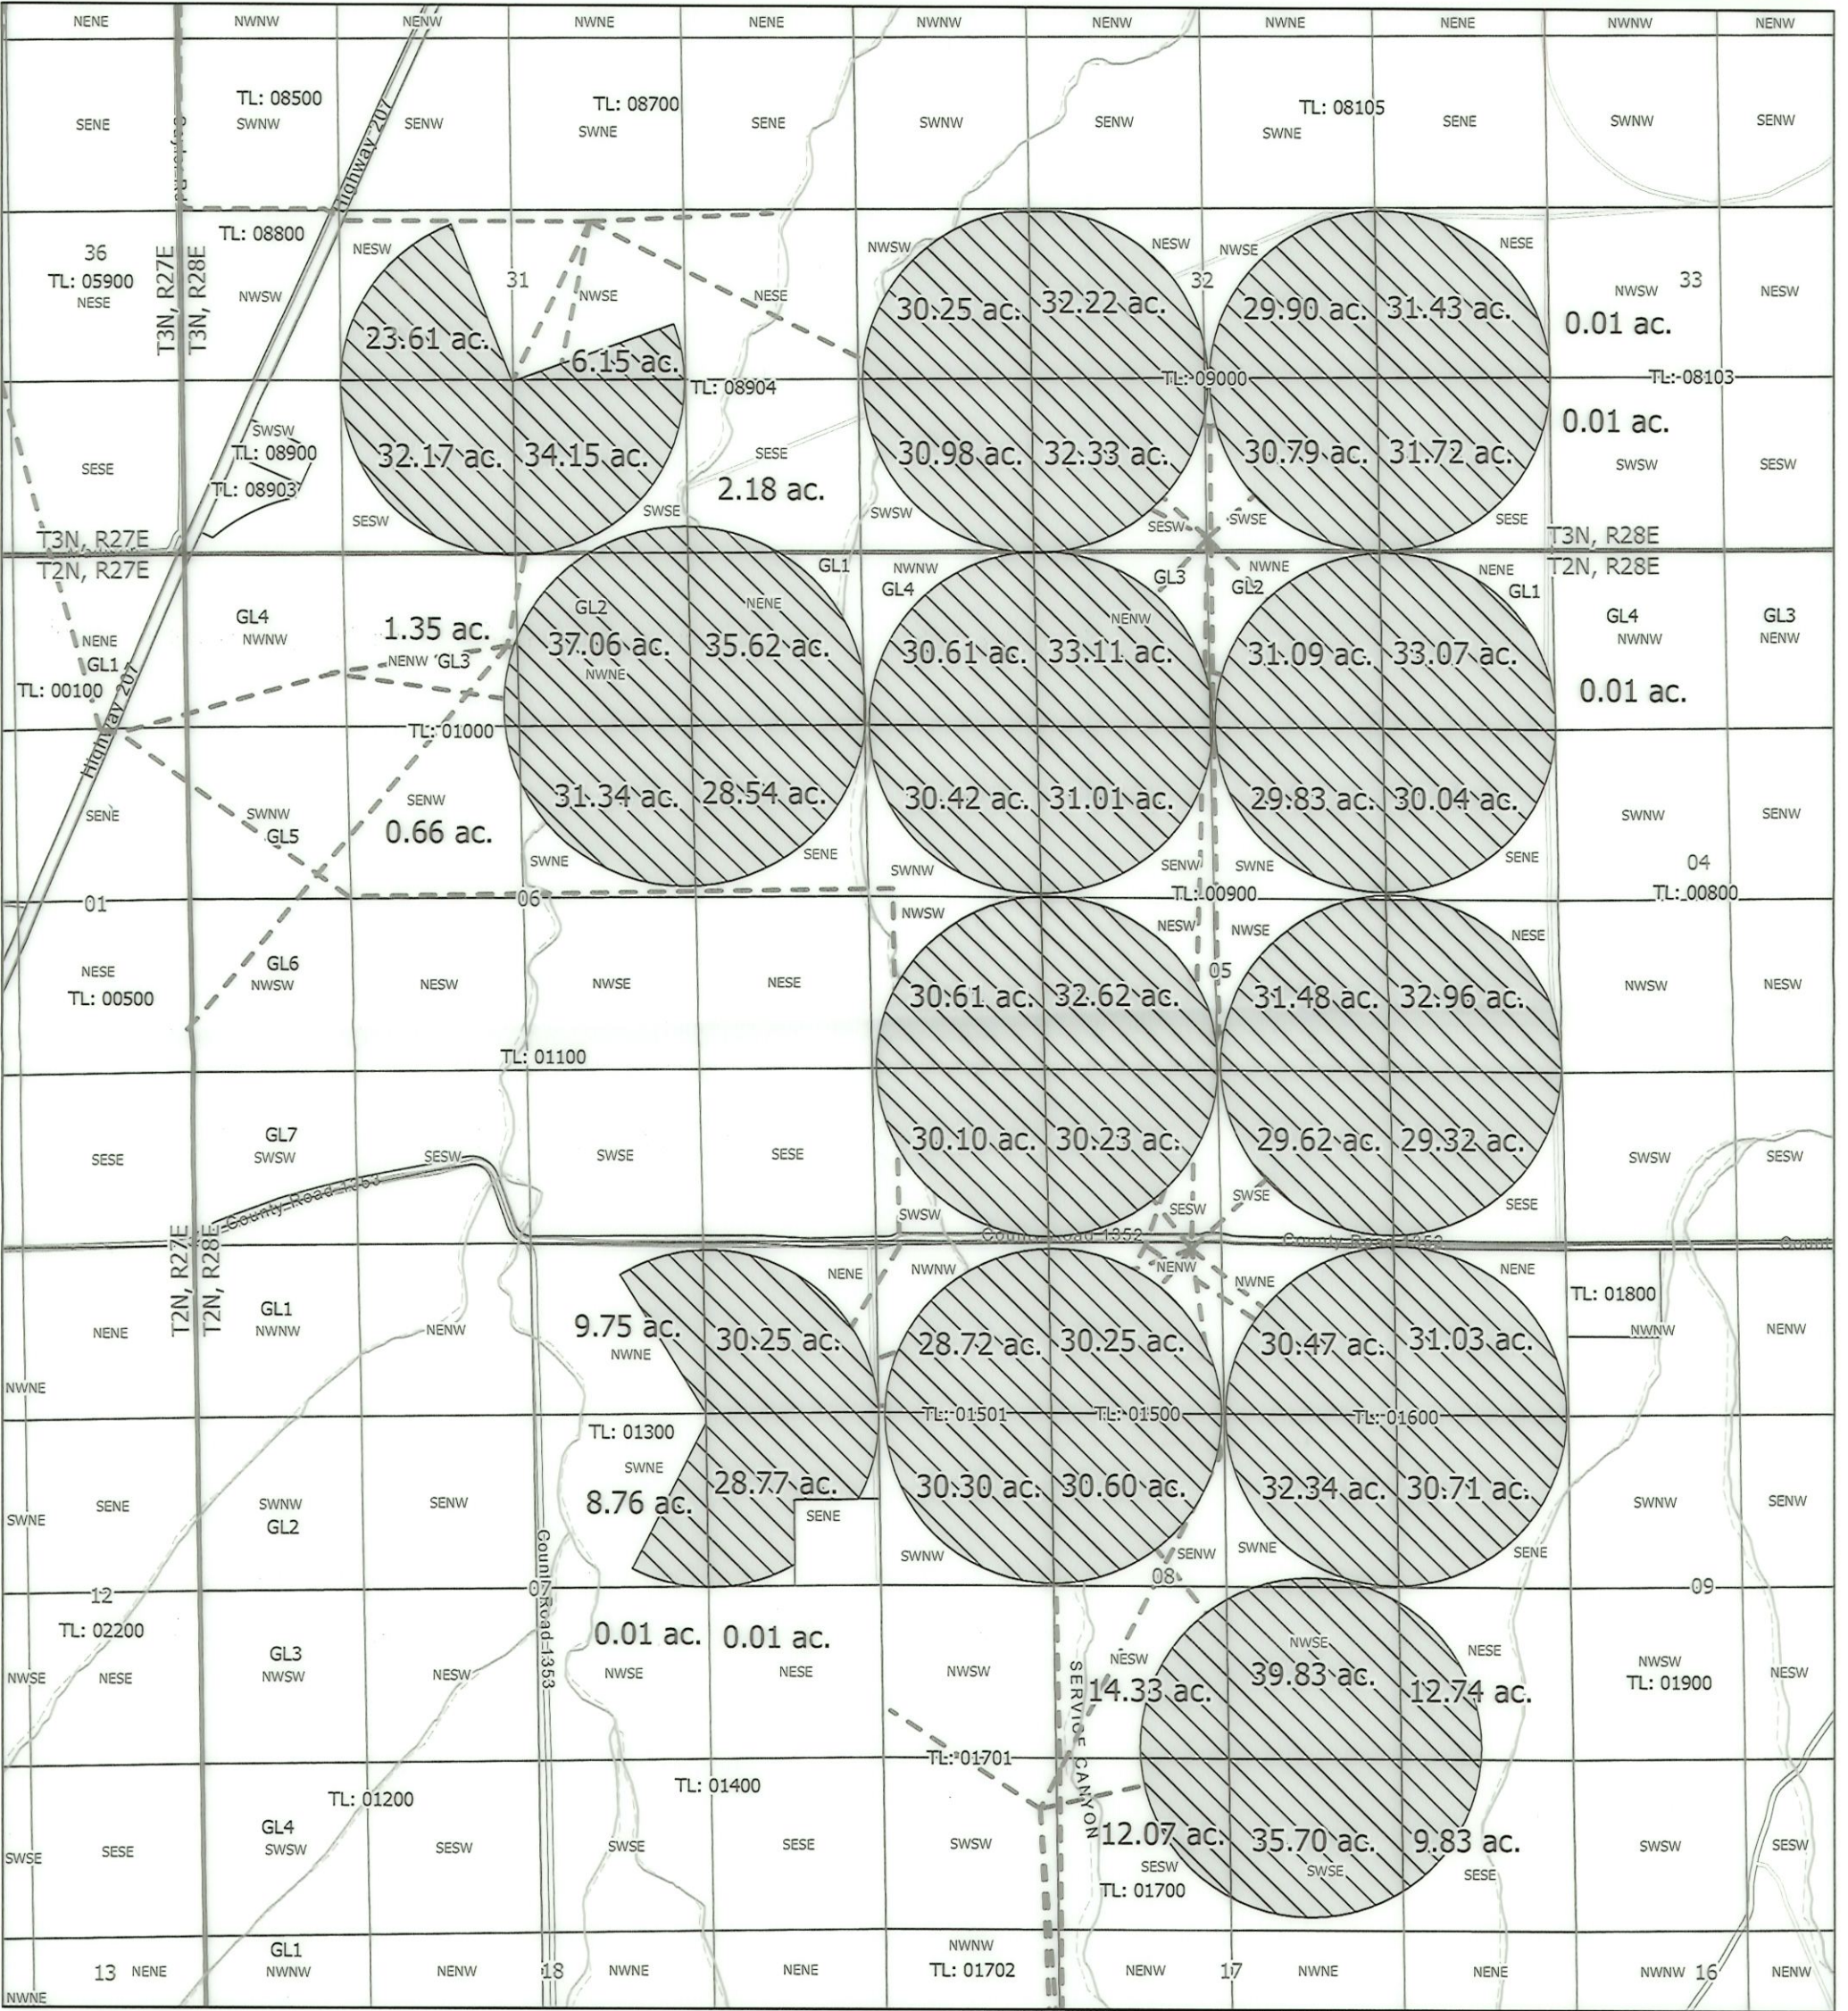

Legend

- Place of Use (1,425.07 acres)
- Pipeline
- Watercourse
- Tax Lot
- Government Lot (GL)

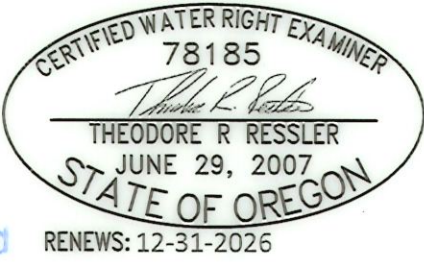

DISCLAIMER

This map was prepared for the purpose of identifying the location of a water right only and it is not intended to provide legal dimensions or location of property ownership lines.

MAP NOTES

Data Sources: BLM, ODFW, OGIC, ESRI, USGS, Umatilla Co.
Current as of: 11/7/2024

Received
APR 04 2025
OWRD



0 690 1,380 Feet


1" = 1,320 feet

Claim of Beneficial Use - Place of Use Map

Transfer T-13525 (former Certificate 92994)


A Water Right in the Name of Farmland Reserve, Inc.

Map 1:
Township 4 N, Range 26 E (W.M.)
Morrow County

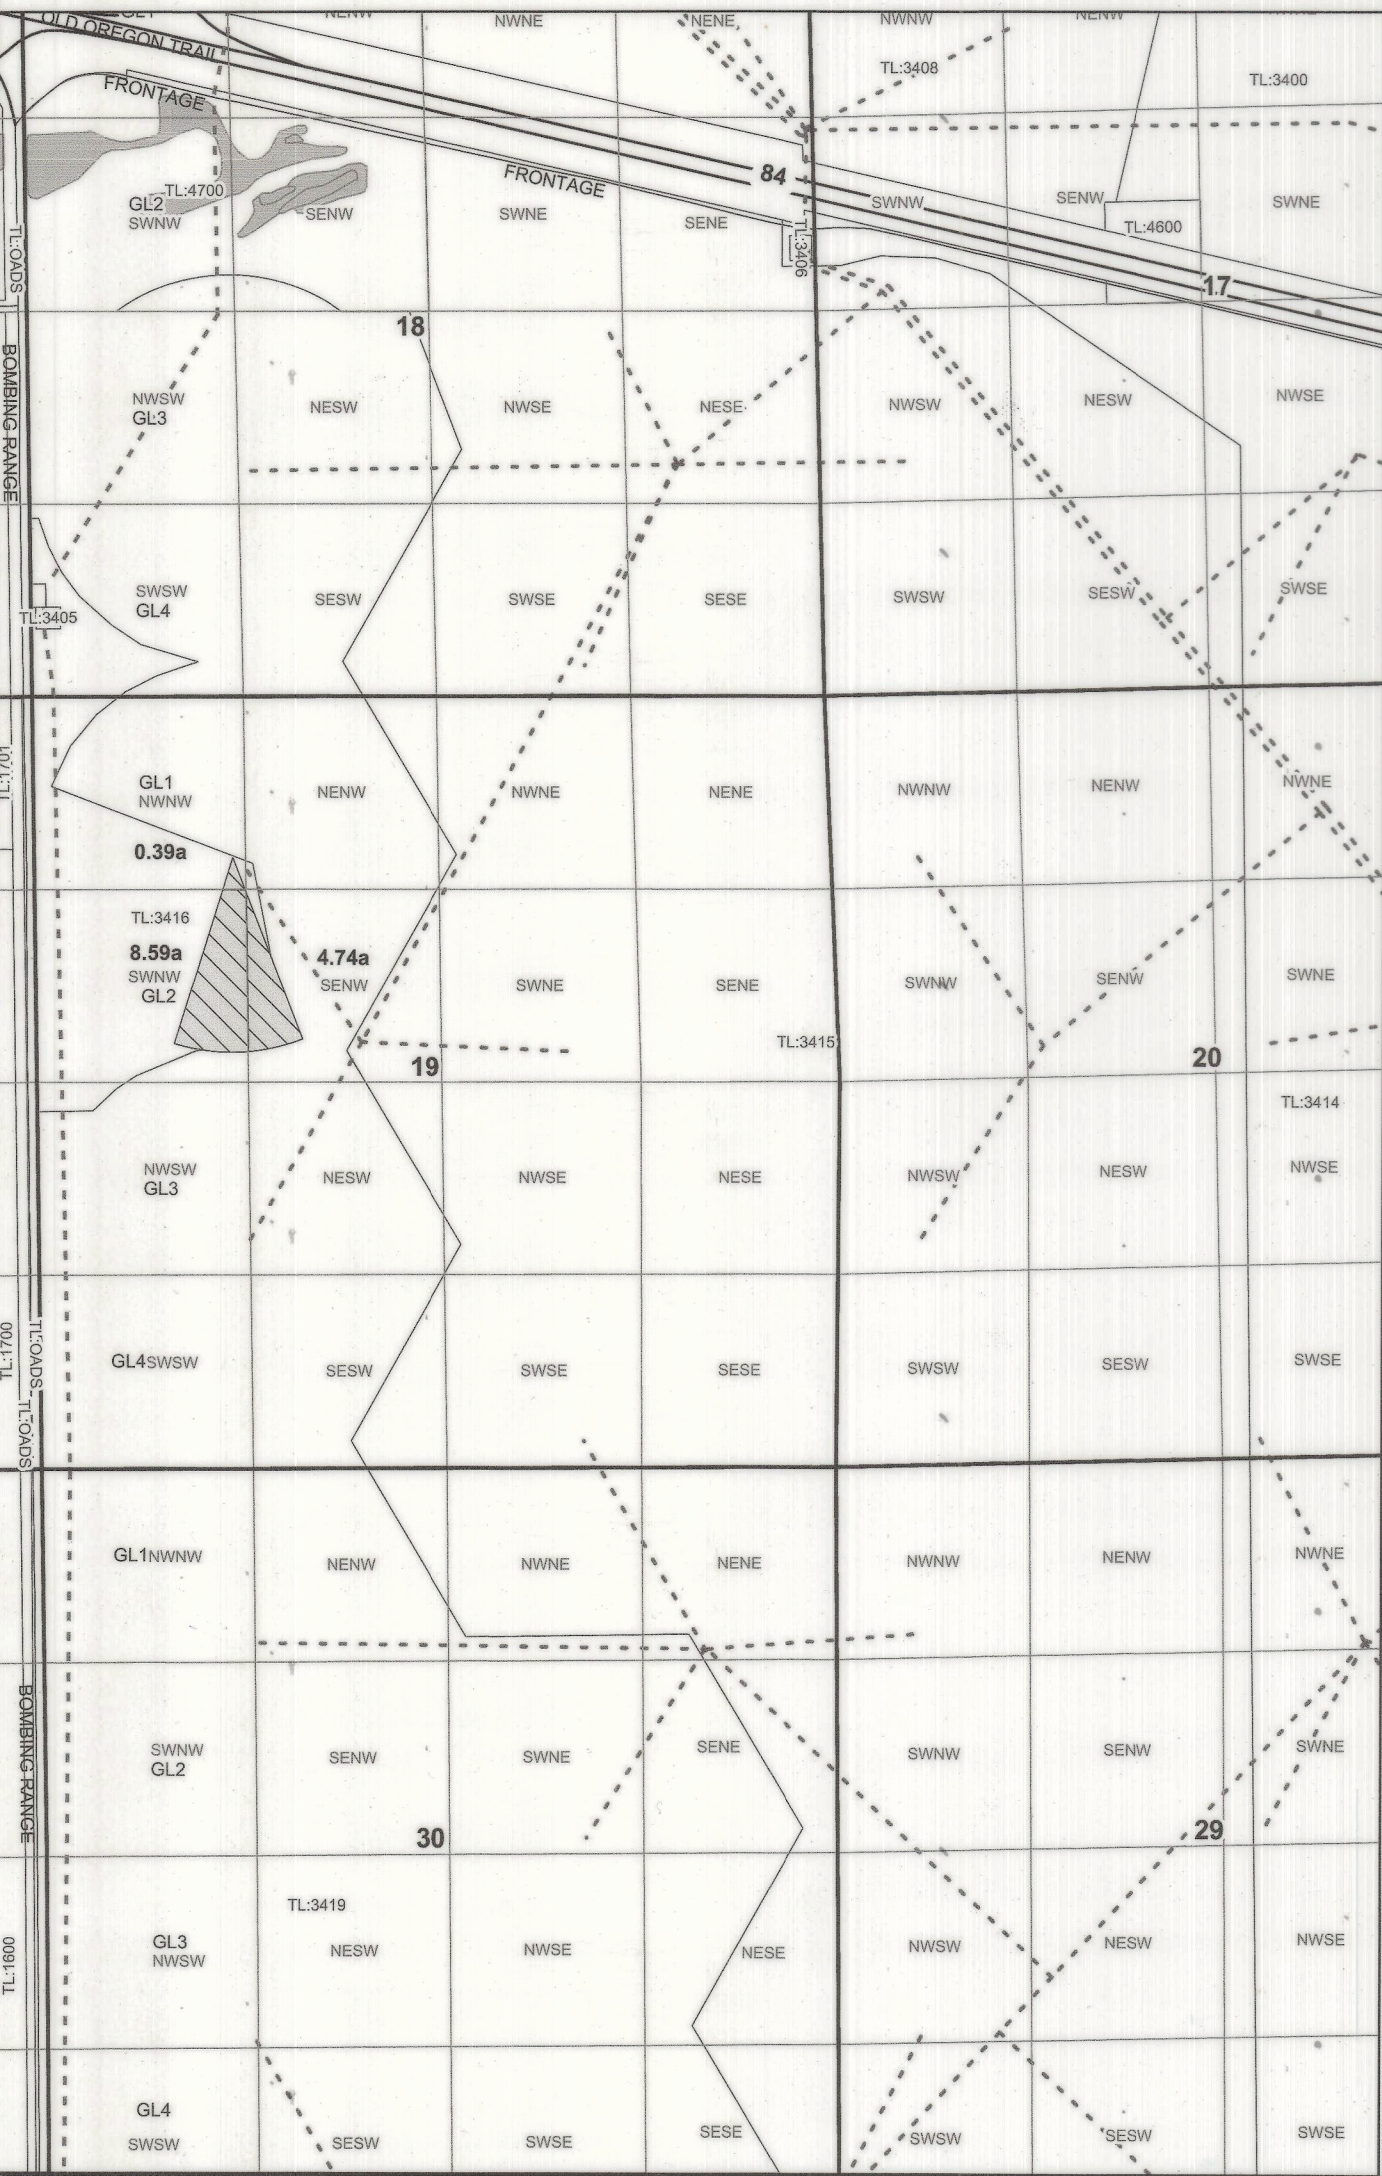

LEGEND
Place of Use (164.90 acres)
Tax Lots
Roads
Railroads
Watercourses
Pipelines

Map 2:
Township 3 N, Range 28 E (W.M.)
Umatilla County

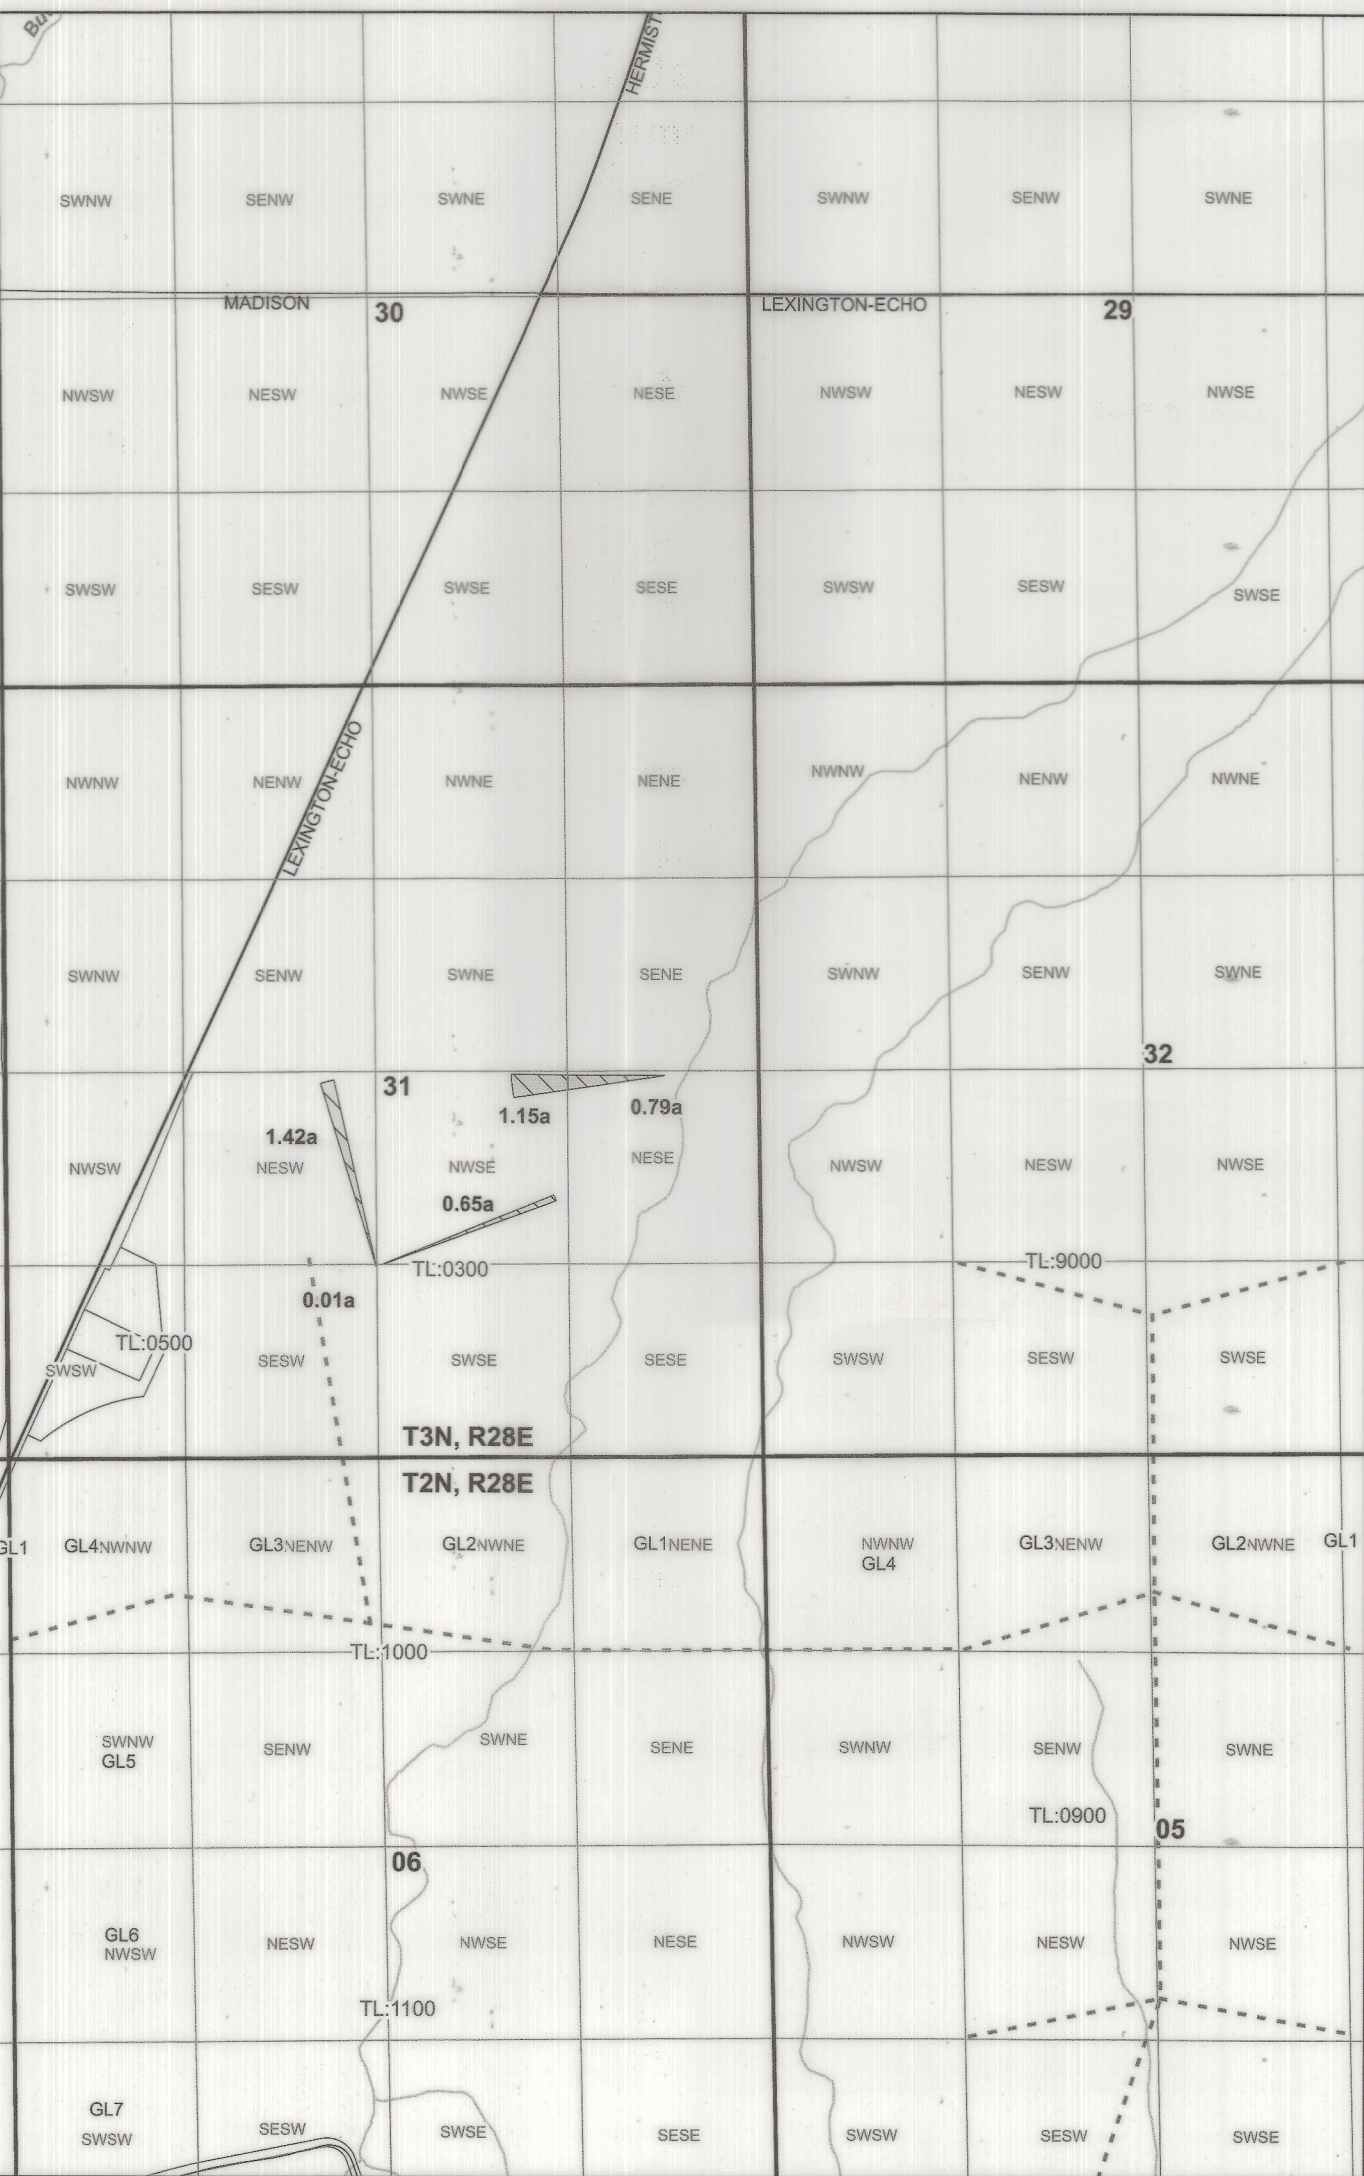

Date: 11/6/2024
Data Sources: BLM,OGIC, ESRI, USGS, Morrow Co.
Disclaimer: This map was prepared for the purpose of identifying the location of a water right only and is not intended to provide legal dimensions or property ownership lines.

Map 3:
Township 2 N, Range 28 E (W.M.)
Umatilla County



Received
APR 04 2025
OWRD

CERTIFIED WATER RIGHT EXAMINER
78185
THEODORE R RESSLER
JUNE 29, 2007
STATE OF OREGON
RENEWS: 12-31-2026



A Water Right in the Name of Farmland Reserve, Inc.

LEGEND

-  Place of Use ($368.93 + 497.83 = 866.76$ acres)
- - - Pipelines
-  Tax Lots
-  Railroads
- Roads
- Watercourses

[illegible]

Date: 11/6/2024
Data Sources: BLM,OGIC, ESRI, USGS, Umatilla Co.
Disclaimer: This map was prepared for the purpose of identifying the location of a water right only and is not intended to provide legal dimensions or location of property ownership lines.

Received
APR 04 2025
OWRD

