

504

POA 1. AUTHORIZED WELL  
Well Log UMAT 50939  
NW SE, Section 32, T6N, R35, WM (TL 504)  
1418 ft N and 22 ft E from S 1/4 Corner Sec 32  
Flowmeter at same location as well.

POA 2. ADDITIONAL WELL  
Well Log UMAT 55959  
SW SE, Section 32, T6N, R35, WM (TL 501)  
950 ft N and 20 ft E from S 1/4 Corner Sec 32  
Flowmeter at same location as well.

POA 1

1300

506

POA 2

501

24.8

0.2

Received  
APR 03 2025  
OWRD

32 33

5 4


SEVEN HILLS RD

Dry Creek

**DISCLAIMER**  
This map is not  
intended to provide  
legal dimensions or  
locations of property  
ownership lines.



1 in = 400 ft

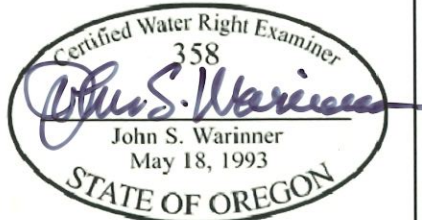

**CLAIM OF BENEFICIAL USE MAP**  
**Transfer 13998**  
**Additional POA**  
**LVHW LLC**  
**Windrow Vineyards**  
**Revised 2025-03-23**