


COPY

Consistent w/
Cert. 27911

Total Acres =
142.1 Ac



T.5S.R.5W.W.M.

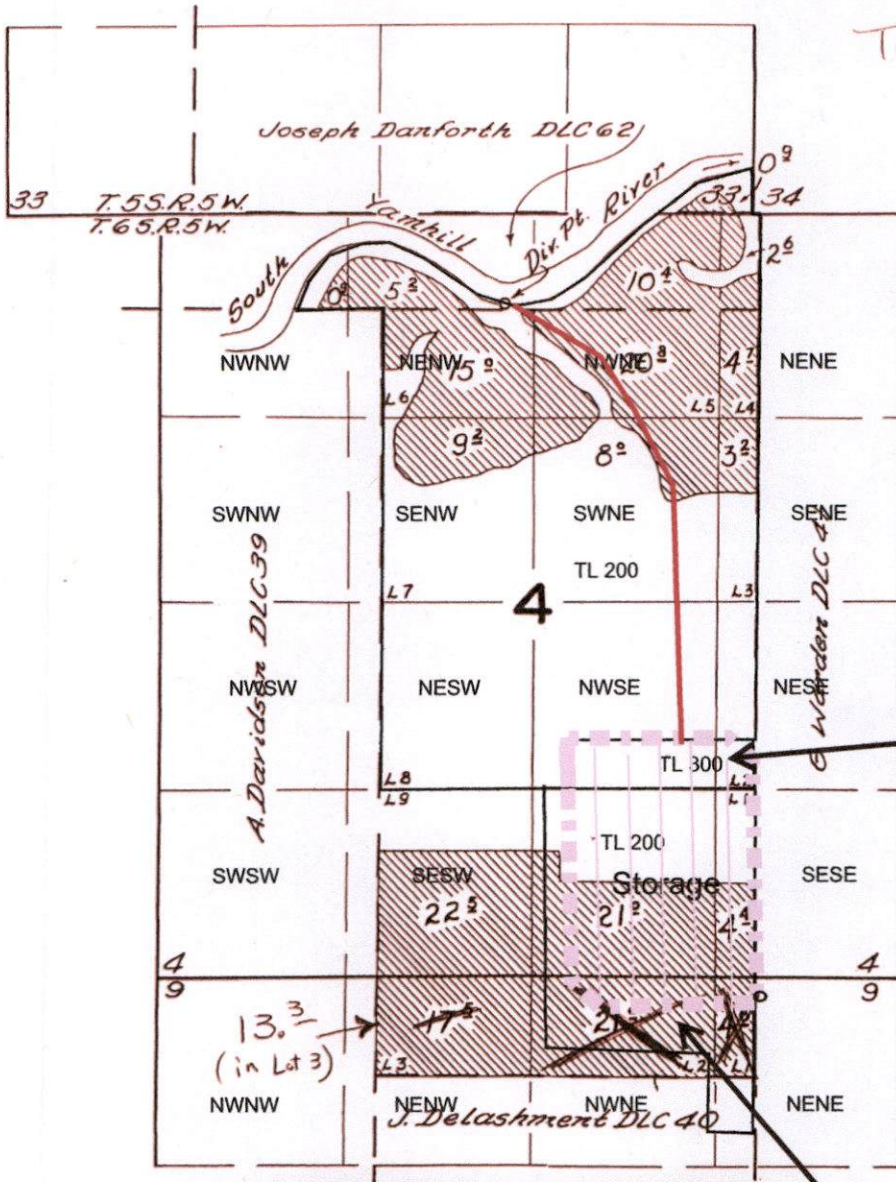

Point of Diversion
6 South, 5 West, Section 4, NENW
660 Feet South and 2470 Feet East
From NW Corner Section 4

1" = 1320'



Place of use for
storage

Head gate control on dam
90 feet south and 1100 feet west from NE
Corner Sec 9

TL 300

~~T.6S R.5W~~

Section 9

Lot 1 = 0.0 Ac

Lot 2 = 0.0 Ac

Lot 3 = 13.3 Ac

FINAL PROOF SURVEY
UNDER

TL 200

IN NAME OF

Received by OWRD

APR 09 2025

Salem, OR