



T2S, R4E, Sec. 29

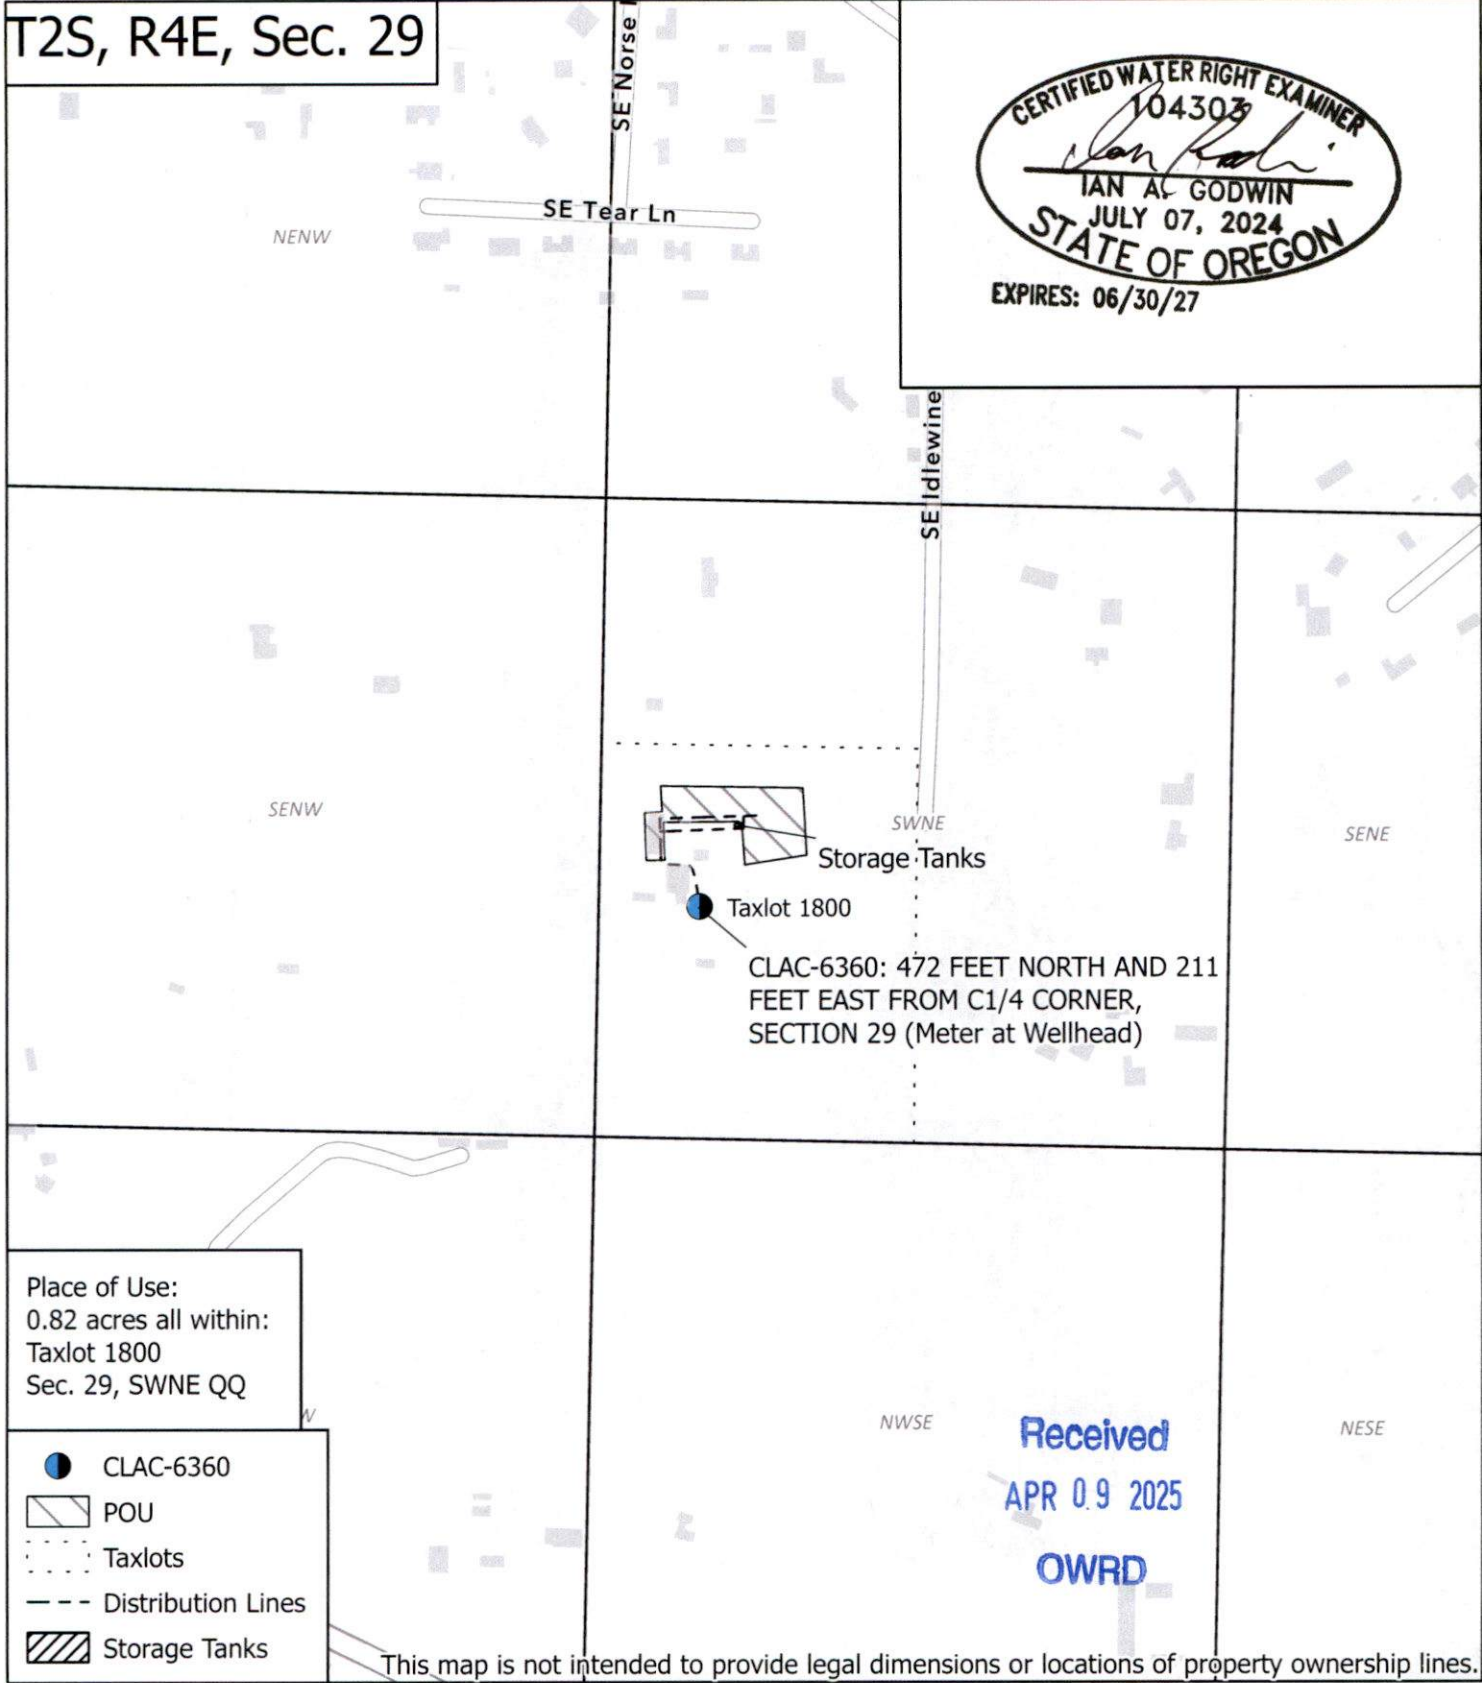

311 B Avenue, Suite P  
Lake Oswego, Oregon 97034  
(503) 954-1326

Claim of Beneficial Use  
Application #: G-18543  
Permit #: G-18165

1	DATE	AUTH	DRAFT
No.	Date	By	Revisions

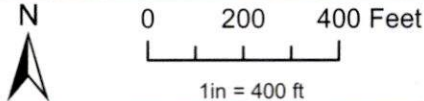

Proj#: 2505001  
Elysian Farms COBU  
Kate Adams  
21285 SE Idlewine Rd  
Eagle Creek, OR 97022