


↑ N

26S 4W 14
+L-300
NESE

* POD
452' West, 400' South
of East 1/4 corner
Section 14

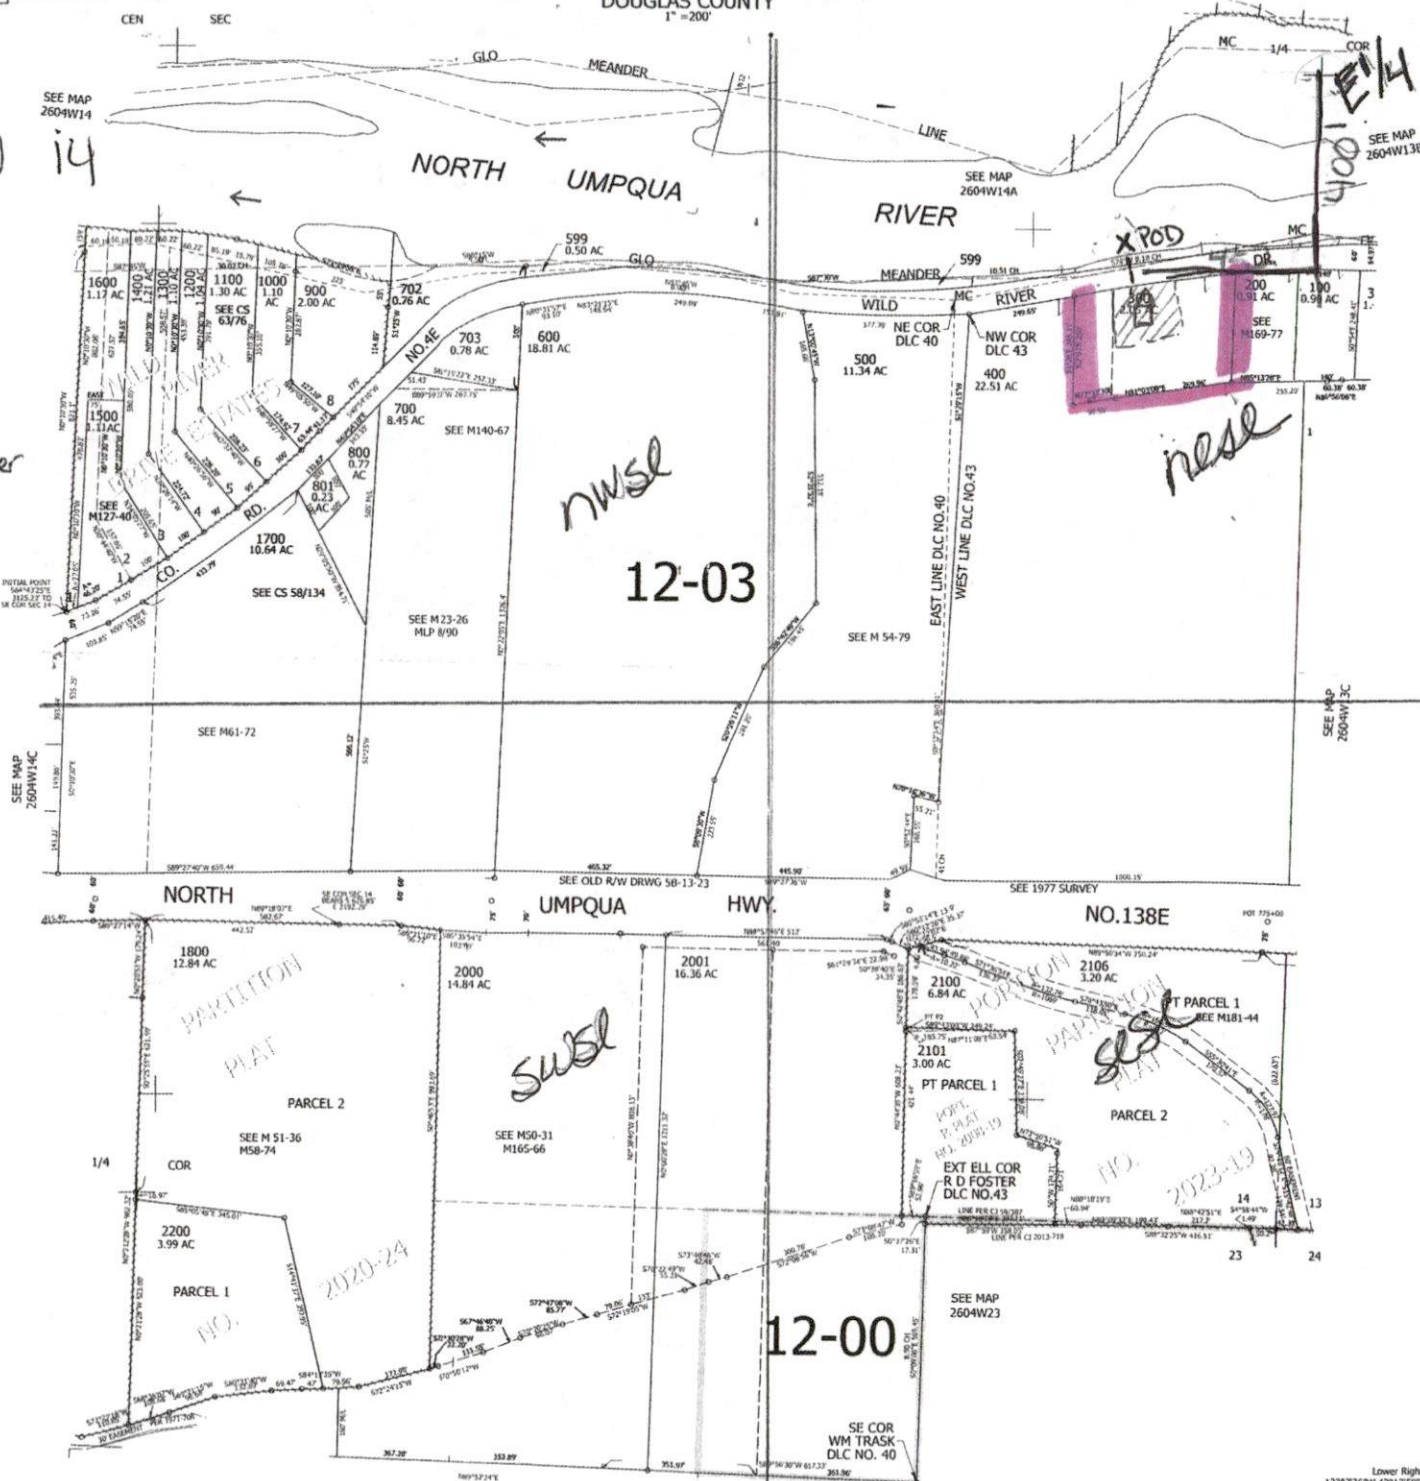

conveyance
line
x=pod

OWPD

APR 10 2025

Received