


T.3S. R.2W. Section 10, W.M.

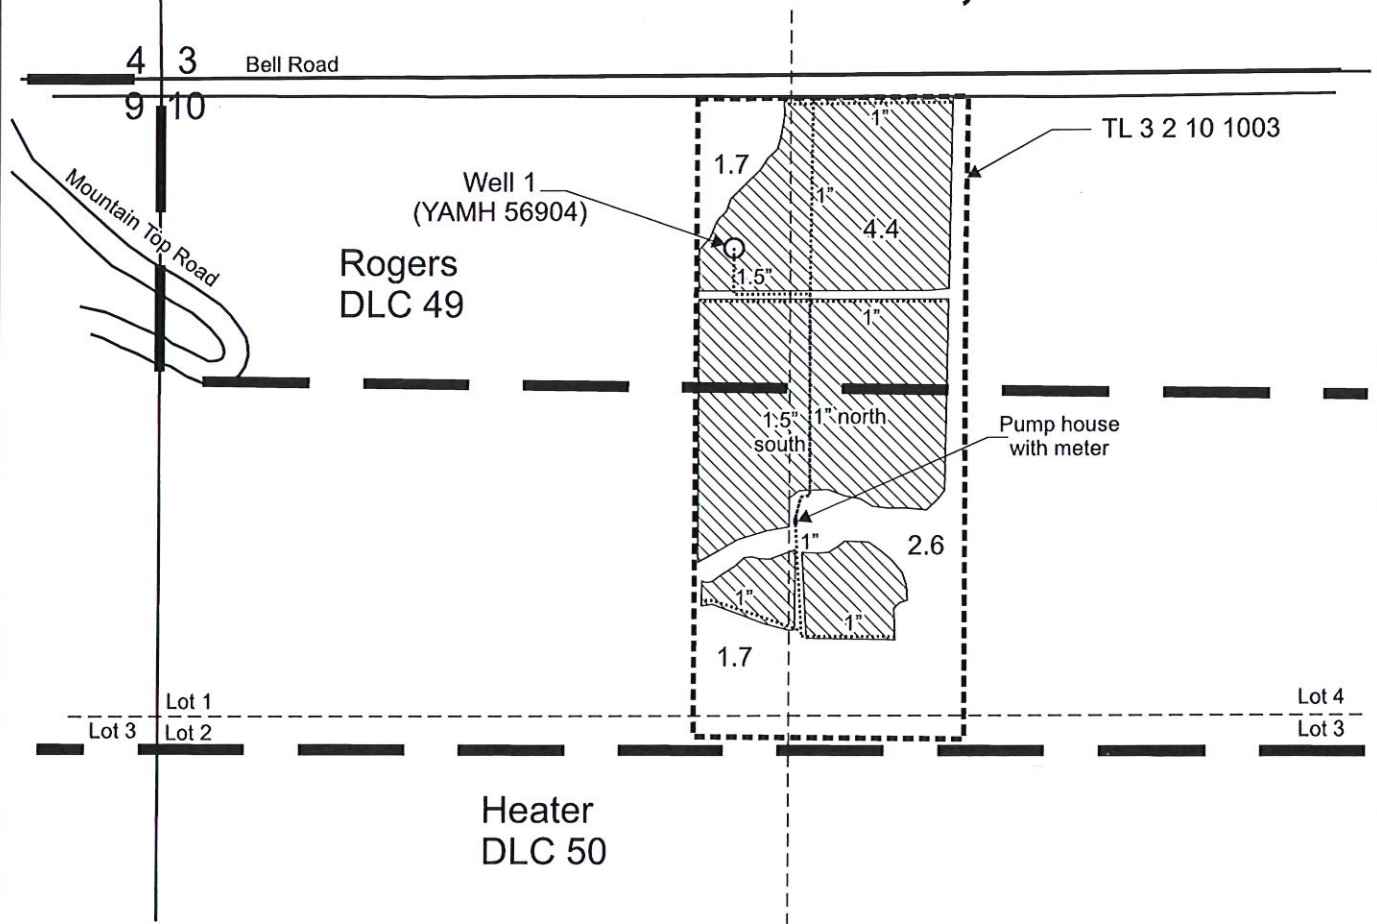

Well 1 (YAMH 56904) is located 355 feet south and 1,200 feet east from the NW corner, Section 10.

 Area (10.4 Acres) irrigated under Application G-17948, Permit G-17512

----- Tax Lot boundary

———— Donation Land Claim boundary

..... Water main line


RECEIVED

JUN 29 2020

OWRD



Scale: 1" = 400'

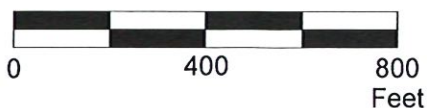

This map was prepared for the purpose of identifying the location of a water right only and is not intended to provide legal dimensions or location of property ownership lines.

Claim of Beneficial Use Map
Application G-17948, Permit G-17512

Michael and Susan Frank
T.3S. R.2W. Section 10, W.M.

Pacific Hydro-Geology Inc.

06/2020