


T14S R13EWM Sec13 SWNE



2/24/2022, 9:20:03 AM


- Override 1 POD
- Township Range
- Sections
- QuarterQuarters
- Pipeline
- QuarterSections
- Canals

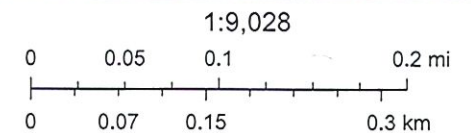

Esri Community Maps Contributors, State of Oregon GEO, ©

North Unit Irrigation District
Copyright North Unit Irrigation District. All Rights Reserved.

44-2002

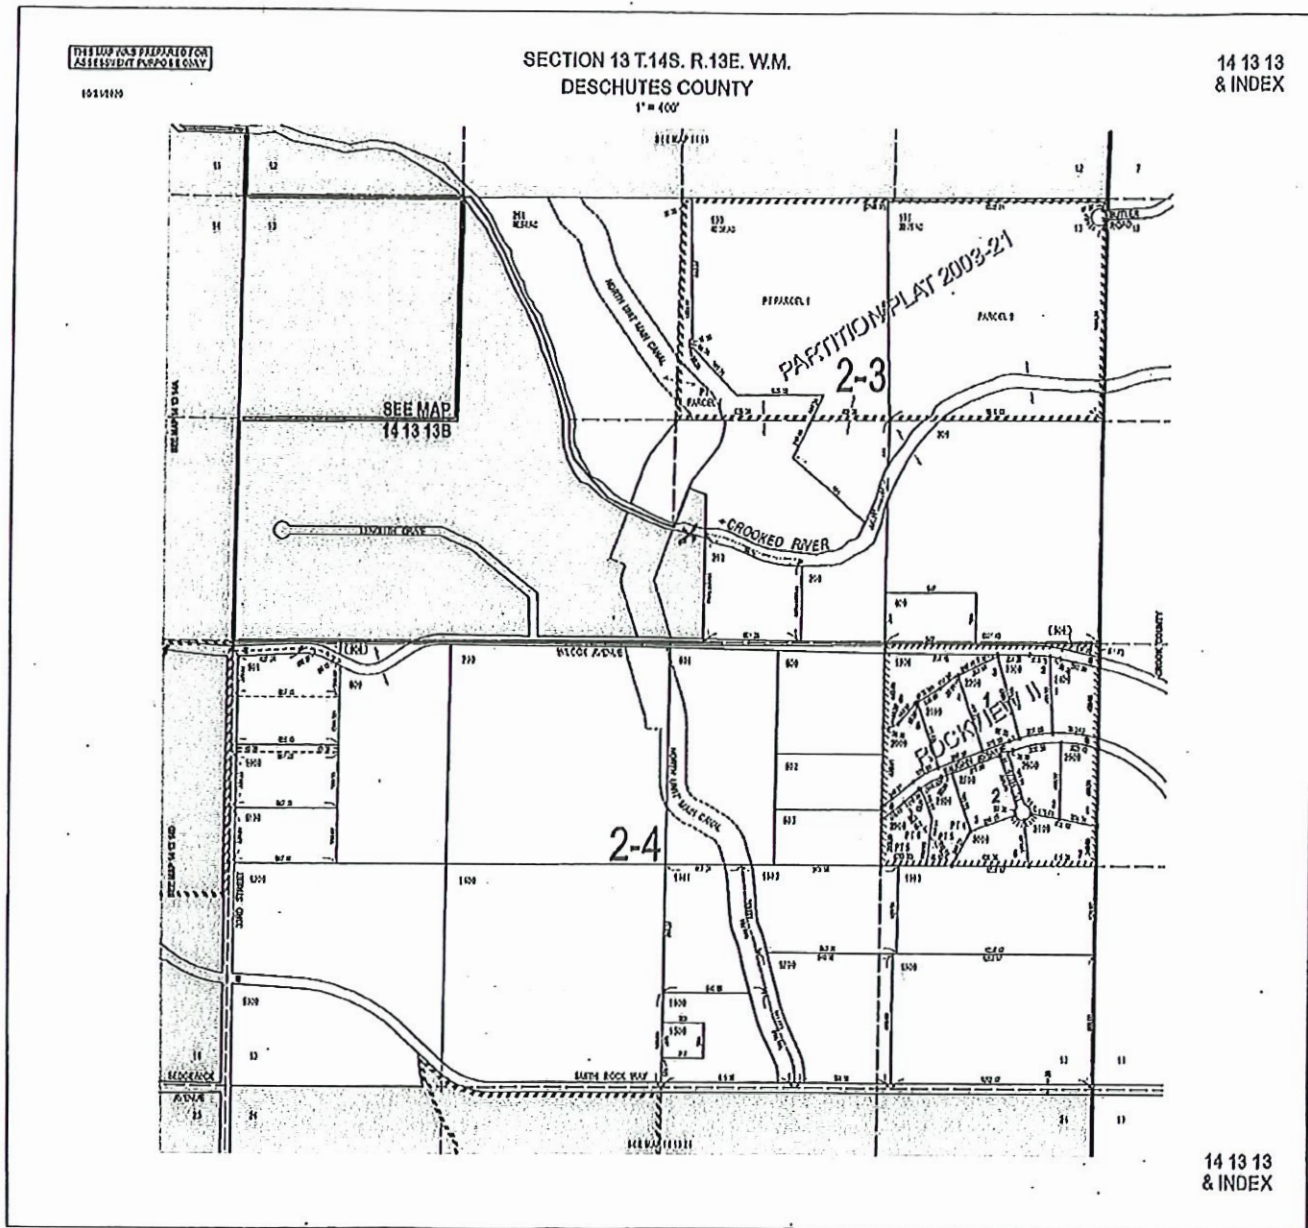

POD T14S R13EWM - 100
Sec 13 SWNE
590' North and
2790' East from
the West 1/4 Corner
of Section 13

Received
APR 14 2025
OWRD

LL-2002