

THIS MAP WAS PREPARED FOR  
ASSESSMENT PURPOSE ONLY.

NE1/4 SEC.16 T.26S. R.4W. W.M.  
DOUGLAS COUNTY

1" = 200'


REVISED ON  
5-23-17

26 4 16A

↑  
N

• POD  
1500ft West, 940 ft South  
from NE corner Section 16

1-hase  
--- conveyance  
NWNE 1/4, 1/4

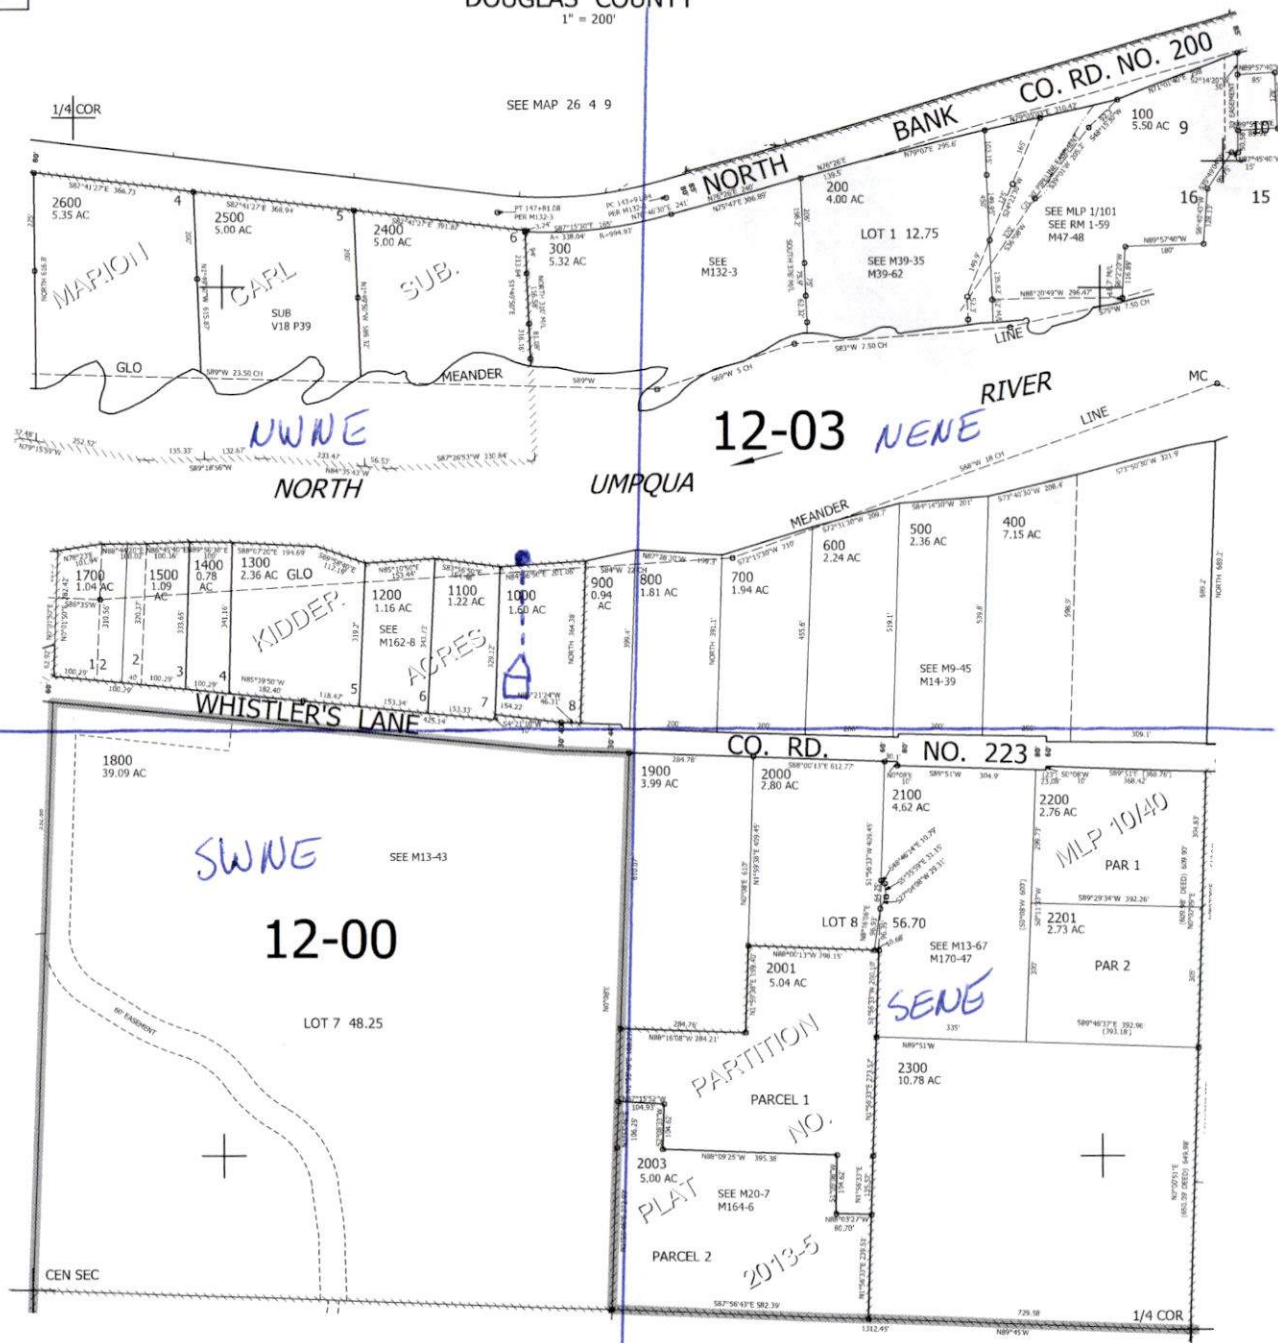

CANCELLED NO'S  
1600 2002 2004  
2101

Received by OWRD  
APR 21 2025

Salem, OR

610,000

26 4 16A