




LEGEND

- Point of Appropriation (POA)
- Conveyance Line
- Place of Use (POU)
- Tax Lot
- Donation Land Survey (DLC)
- Government Lot (GL)
- Major Road
- Watercourse
- Waterbody

CERTIFIED WATER RIGHTS EXAMINER STAMP

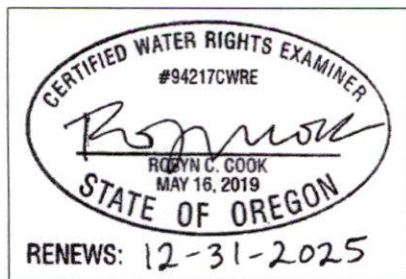

LOCATION DESCRIPTION

Holbrook Well 2 (YAMH 6439)
 Located 2,120 feet North and 675 feet East from the NW corner of DLC 56, Township 5 South, Range 3 West (W.M.)

Well 3 (YAMH 59179)
 Located 520 feet North and 1,275 feet East from the NW corner of DLC 56, Township 5 South, Range 3 West (W.M.)

Claim of Beneficial Use Map Application G-1525; Transfer T-13527

Yamhill County

Township 5 South, Range 3 West (W.M.)

Received
 APR 24 2025
 OWRD

DISCLAIMER

This map was prepared for the purpose of identifying the location of a water right only and it is not intended to provide legal dimensions or location of property ownership lines.

Date: September 24, 2024
 Data Sources: BLM, ESRI, OWRD, USGS

