
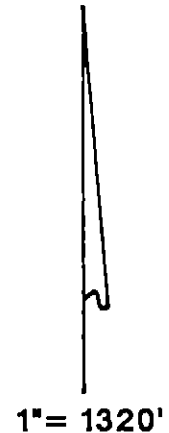


T.5S., R.1E., W.M.

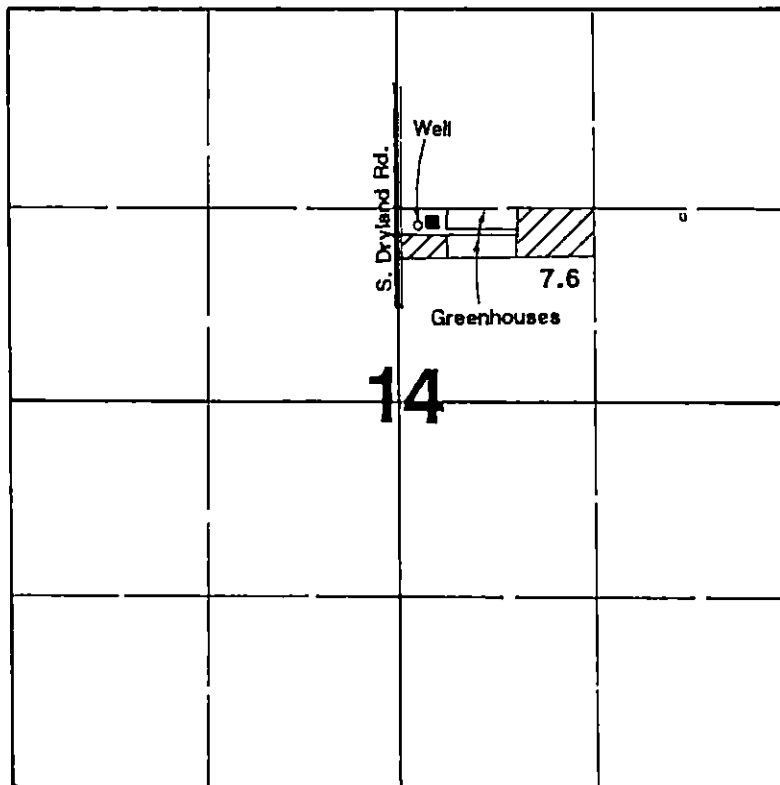

Well located 1460'S & 2510' W of NE corner Section 14.

Final Proof Survey

Application #: G-12542 Permit #: G-11321

In Name Of

Charles Lucht

Surveyed on September 12, 1995 by James Grimm

