




MARION COUNTY, OREGON
NE1/4 SEC35 T4S R1W W.M.
SCALE 1" = 200'

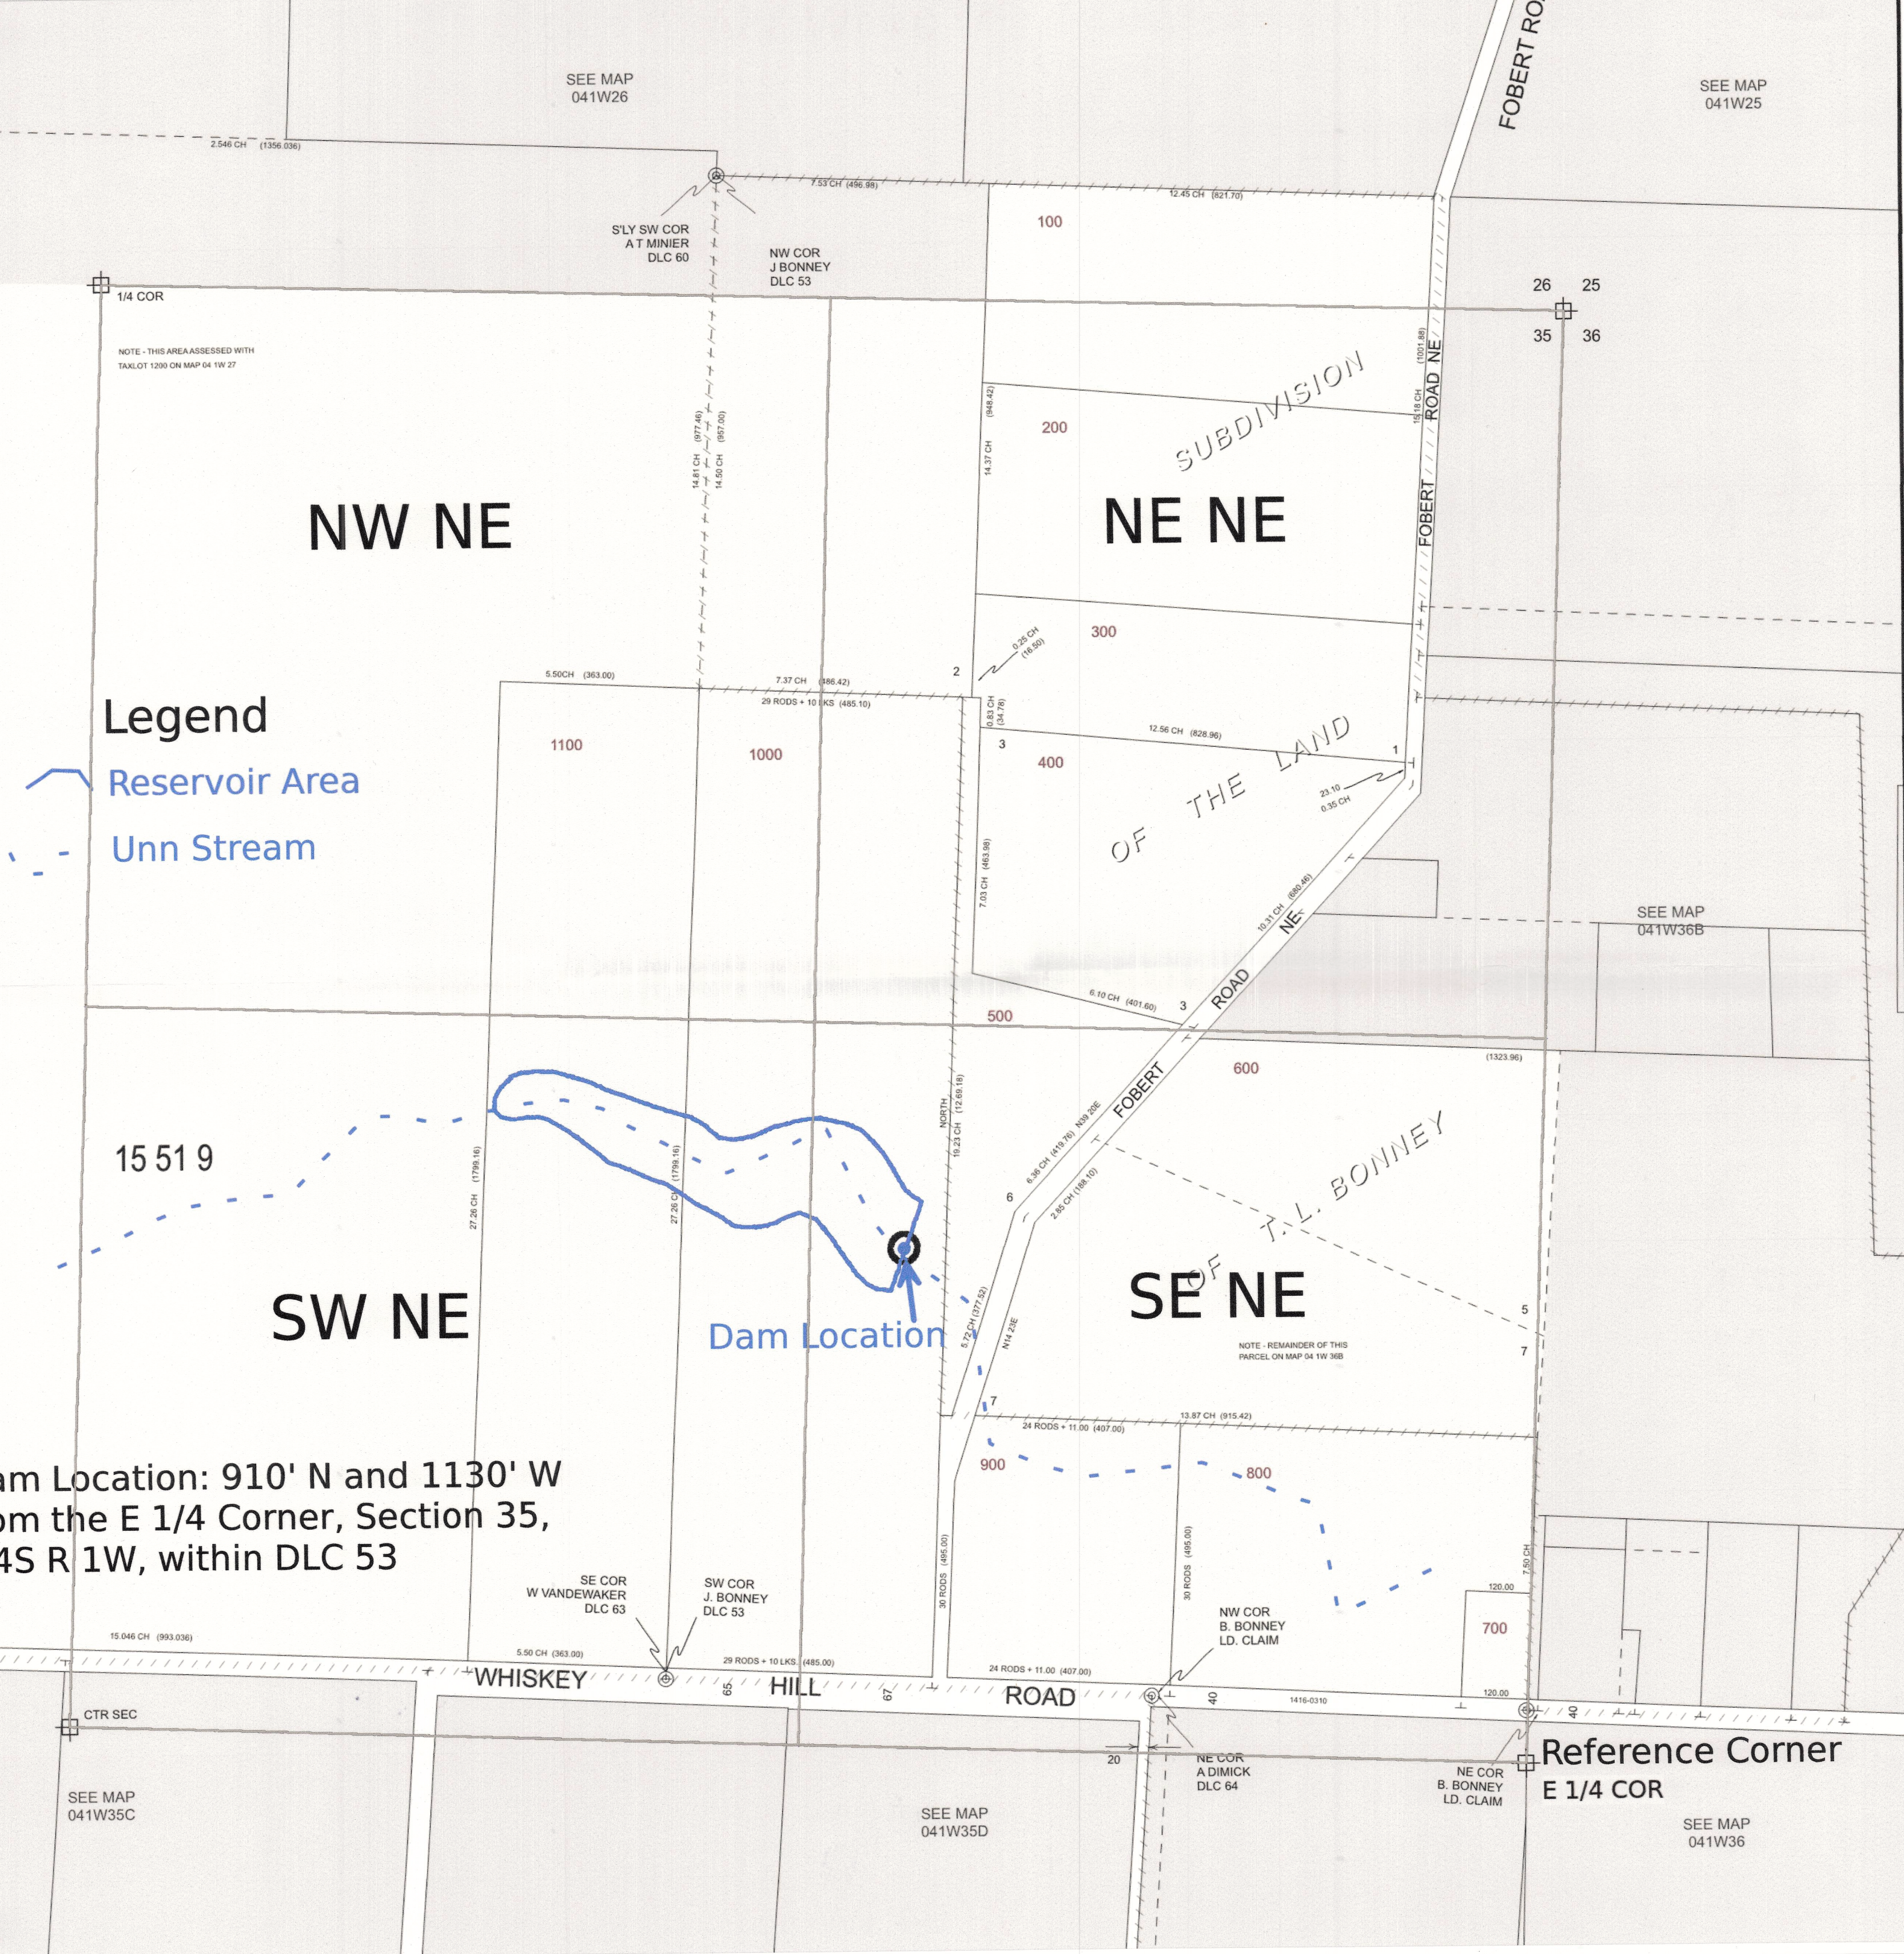

Legend
Reservoir Area
Unn Stream

LEGEND
LINE TYPES
Taxlot Boundary
Road Right-of-Way
Railroad Right-of-Way
Private Road ROW
Subdivision/Plat Bndry
Waterline - Taxlot Bndry
Historical Boundary
Easement
Railroad Centerline
Taxcode Line
Map Boundary
Waterline - Non Bndry

CORNER TYPES
+ 1/16TH Section Cor.
⊙ DLC Corner
⊕ 1/4 Section Cor.
⊕ Section Corner
16 15
21 22

NUMBERS
Tax Code Number
00 00 0
Acreage
0.25 AC
All acres listed are Net Acres, excluding any portions of the taxlot within public ROWs

NOTES
Tick Marks: A tick mark in the road indicates that the labeled dimension extends into the public ROW
175.00 200.00

CANCELLED NUMBERS

--	--	--	--

Dam Location: 910' N and 1130' W from the E 1/4 Corner, Section 35, T 4S R 1W, within DLC 53

DISCLAIMER: THIS MAP WAS PREPARED FOR ASSESSMENT PURPOSES ONLY

Received
APR 23 2025
OWRD

FOR ADDITIONAL MAPS VISIT OUR WEBSITE AT www.co.marion.or.us

PLOT DATE: 10/16/2020