



Section 3, T1N, R4W, W.M. and
Sections 33 & 34, T2N, R4W, W.M.,
Washington County, Oregon

GROUNDWATER PERMIT APPLICATION MAP
RLK Smith Orchards

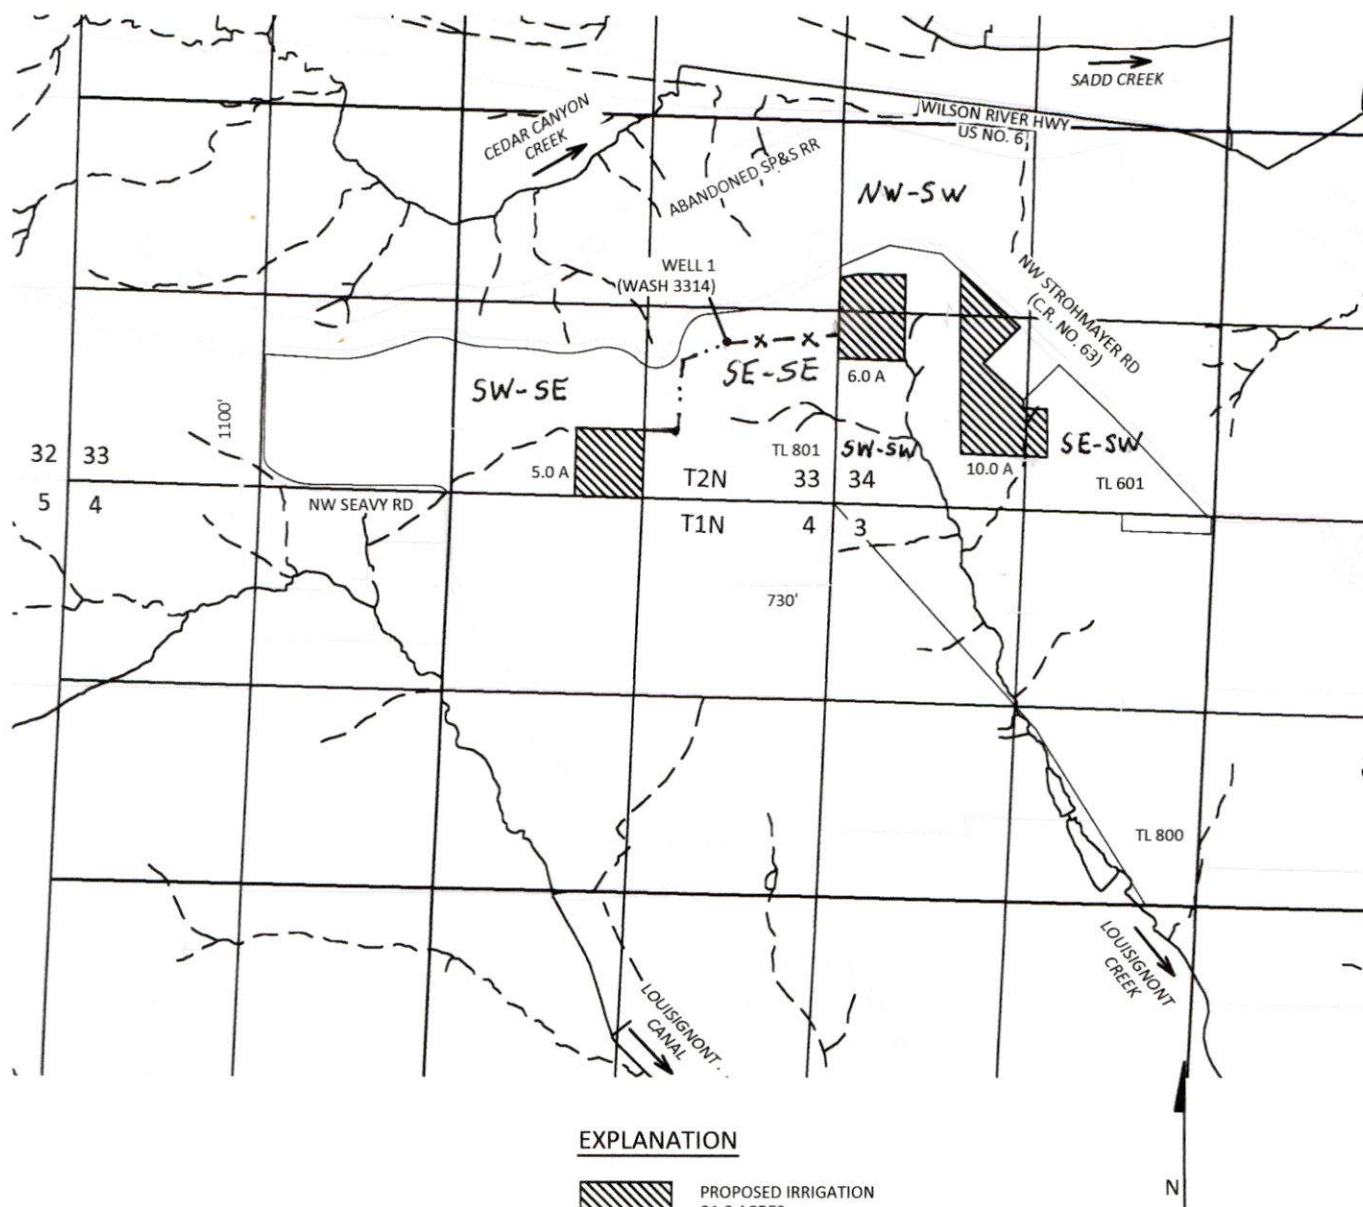

EXPLANATION

- PROPOSED IRRIGATION
21.0 ACRES
- WELL
- PIPE
- PROPOSED PIPE
(MAY - JUNE 2025)

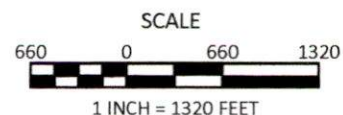

March 24, 2025

This map is not intended to provide legal
dimensions or locations of property
ownership lines

Figure 1

kpff

111 SW Fifth Ave., Suite 2400
Portland, OR 97204
O: 503.227.3251
F: 503.274.4681
www.kpff.com

Received
APR 30 2025
OWRD

Received
APR 17 2025
OWRD