
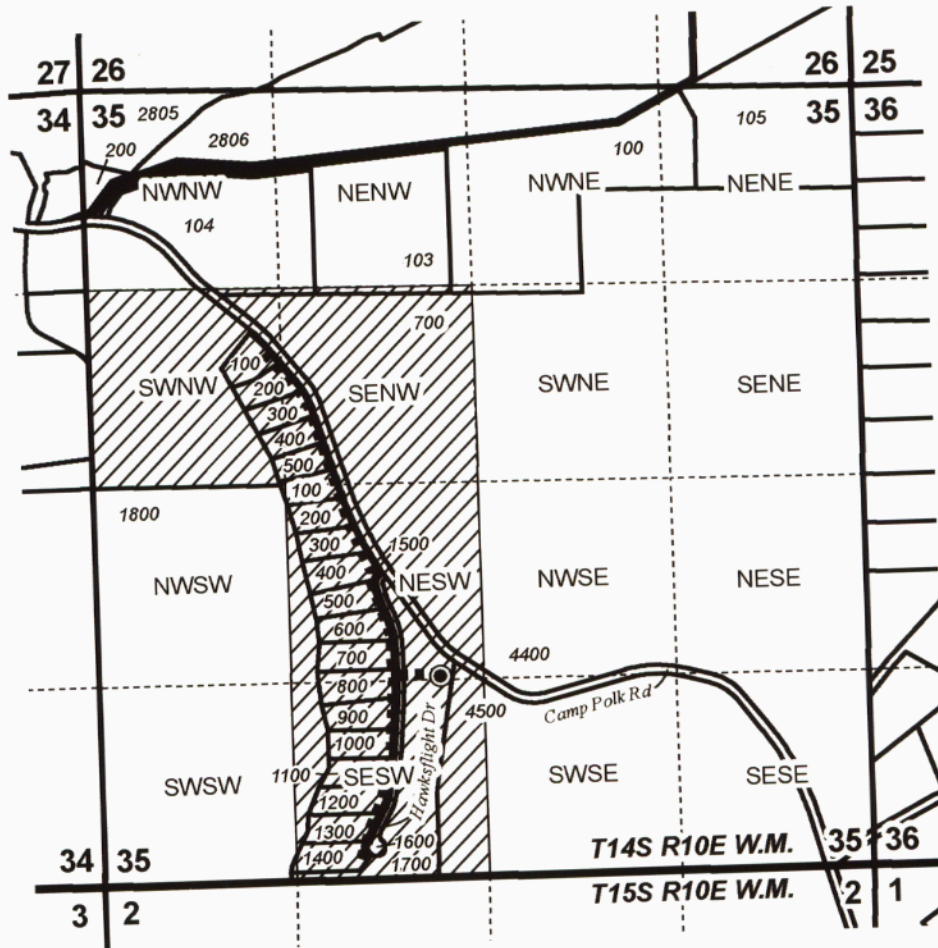



T14S R10E, WM DESCHUTES COUNTY, OR

- Well, Storage Tank, Pumps
- Pipeline
- ▨ POU QM
- Township
- Section
- Quarter Quarter
- Tax Lot

Well (DESC 0001) Location:
1372' N, 2343' E of SW Cor Sec 35

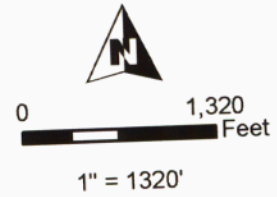

Received
APR 28 2025
OWRD

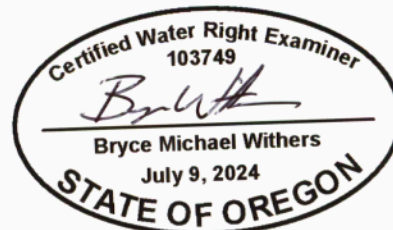

RENEWS: 06/30/2026



CLAIM OF BENEFICIAL USE MAP
Aspen Lakes Development, LLC

Date: 4/9/2025

Ap G-12042 Permit G-11146

This map is not intended
to provide legal dimensions
or locations of property
ownership lines.

WATER RIGHT SERVICES, LLC
PO BOX 1830, BEND, OR 97709
WWW.OREGONWATER.US CCB # 197121
johnshort@usa.com 541-389-2837