

MAP FOR


Claim of Beneficial Use

S33, T5S, R3W, Yamhill County

Appl G-16352, Permit G-15984



1 IN = 1320 FT
0 660 1320

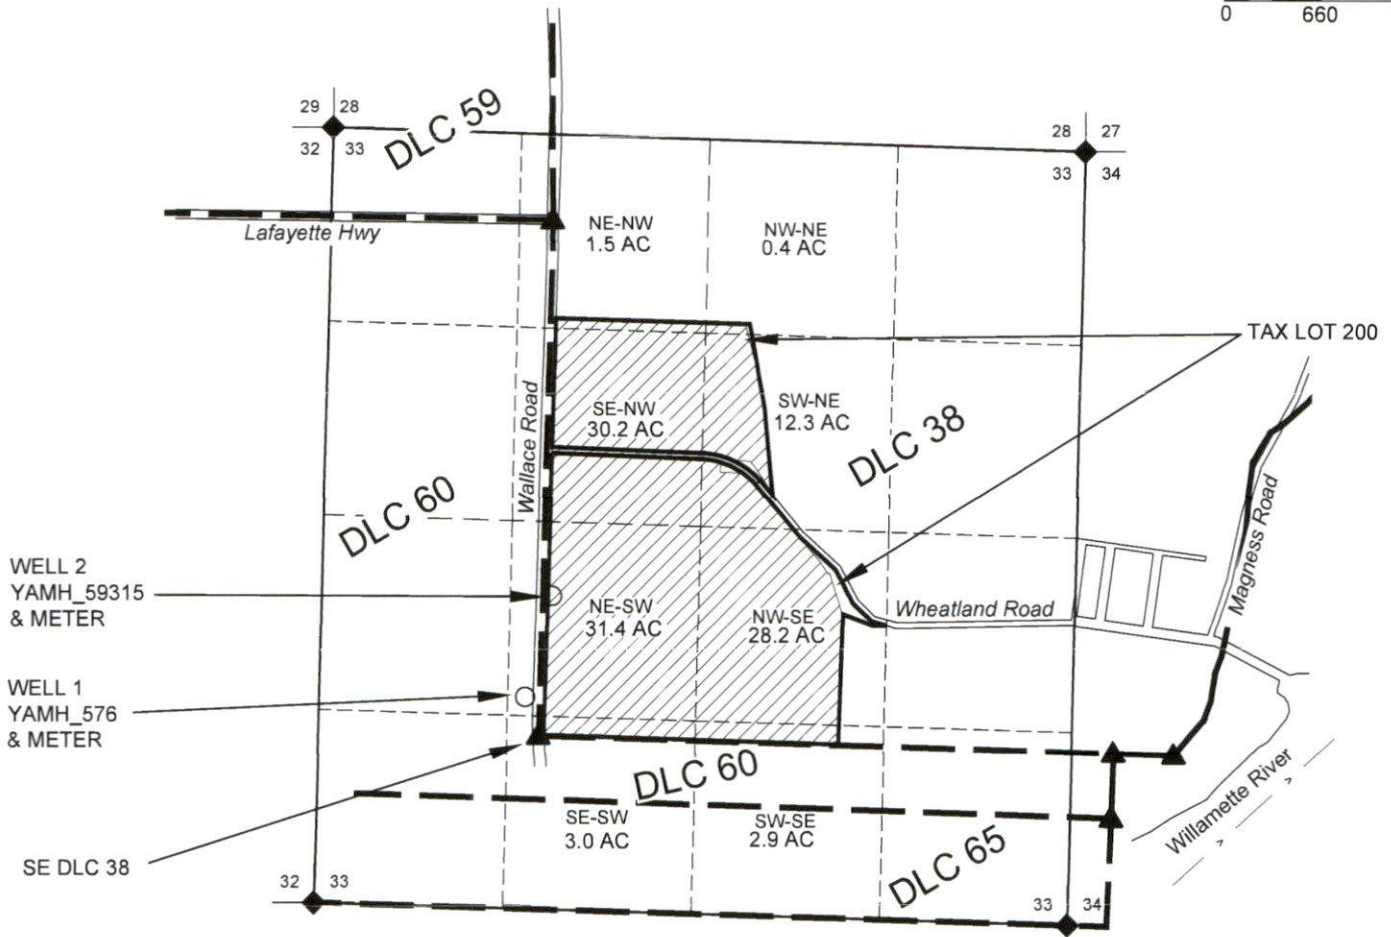

LOCATIONS OF POA'S
 WELL #1 265 FEET NORTH AND 90 FEET WEST OF SE DLC 38
 WELL #2 950 FEET NORTH AND 95 FEET EAST OF SE DLC 38.

- NOTES:
- THIS MAP IS NOT INTENDED TO PROVIDE LEGAL DIMENSIONS OR LOCATIONS OF PROPERTY OWNERSHIP LINES.
 - PROPERTY, QUARTER-QUARTER, AND DLC LINES ARE BASED ON THE TAX ASSESSOR MAP FOR SECTION 33, TS, R3W.
 - IRRIGATION IS BASED ON A GOOGLE AERIAL PHOTO AND FIELD OBSERVATION.
 - WATER CONVEYANCE LINES ARE ALL WITHIN THE PROPERTY AND THEREFORE ARE NOT SHOWN.

LEGEND

- DONATION LAND CLAIM (DLC) CORNER
- SECTION CORNER
- POINT OF APPROPRIATION (POA)
- STREAM OR SURFACE DRAINAGE
- TAX LOT LINE
- SECTION LINE
- QUARTER-QUARTER LINE
- DLC LINES
- CONVEYANCE LINES
- IRRIGATION



Exp. 30 JUN 2026

Received
 MAY 02 2025
 OWRD

MAP BY:
ASPEN RURAL LAND CONSULTING
 ERIC URSTADT, PE, PLS
 971-250-1520
 JAN 2025
 WWL-Wheatland1H