


E-RECEIVED
MAY 7, 2025
OWRD

N
|

T. 6 & 7 S., R. 2 W., W.M.

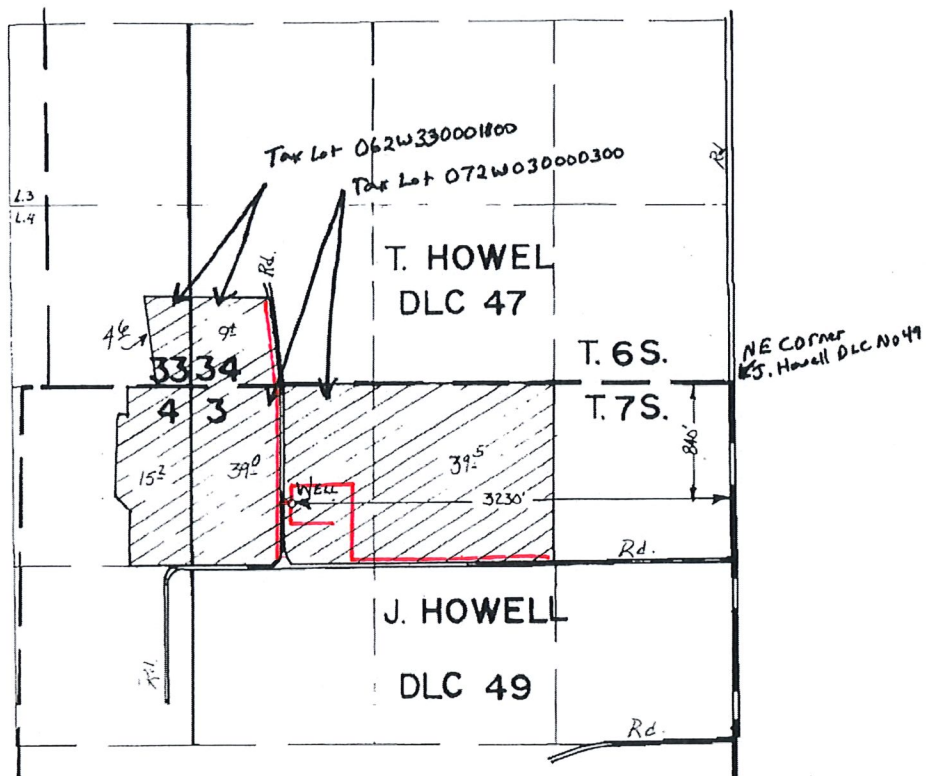

SCALE 4" = 1 MI

— = pipeline

Pipeline west of the pump goes through
a culvert tile across the road. It is
5" aluminum pipe that can be removed
as needed. County has approved this verbally.

Acres - Nursery
4.6
9.4
39.5
39
15.2
107.7 Acres - Nursery

RECEIVED
DEC 12 2023
OWRD