

Upper Left:
123°21'30"W 43°25'13"N
4151189E 652199N R

SEC.11 T.25S. R.06W. W.M.
DOUGLAS COUNTY
1"=400'

Date Exported 2023-08-01


250611

CANCELLED NOS:
401

PARCEL 402
1. N13°09'E 62.47'
2. N23°27'W 34.0'
3. N15°07'W 44.2'
4. N1°23'36'W 113.25'

930' North and
750' West from
Center of Section 11

Received
MAY 05 2025
OWRD

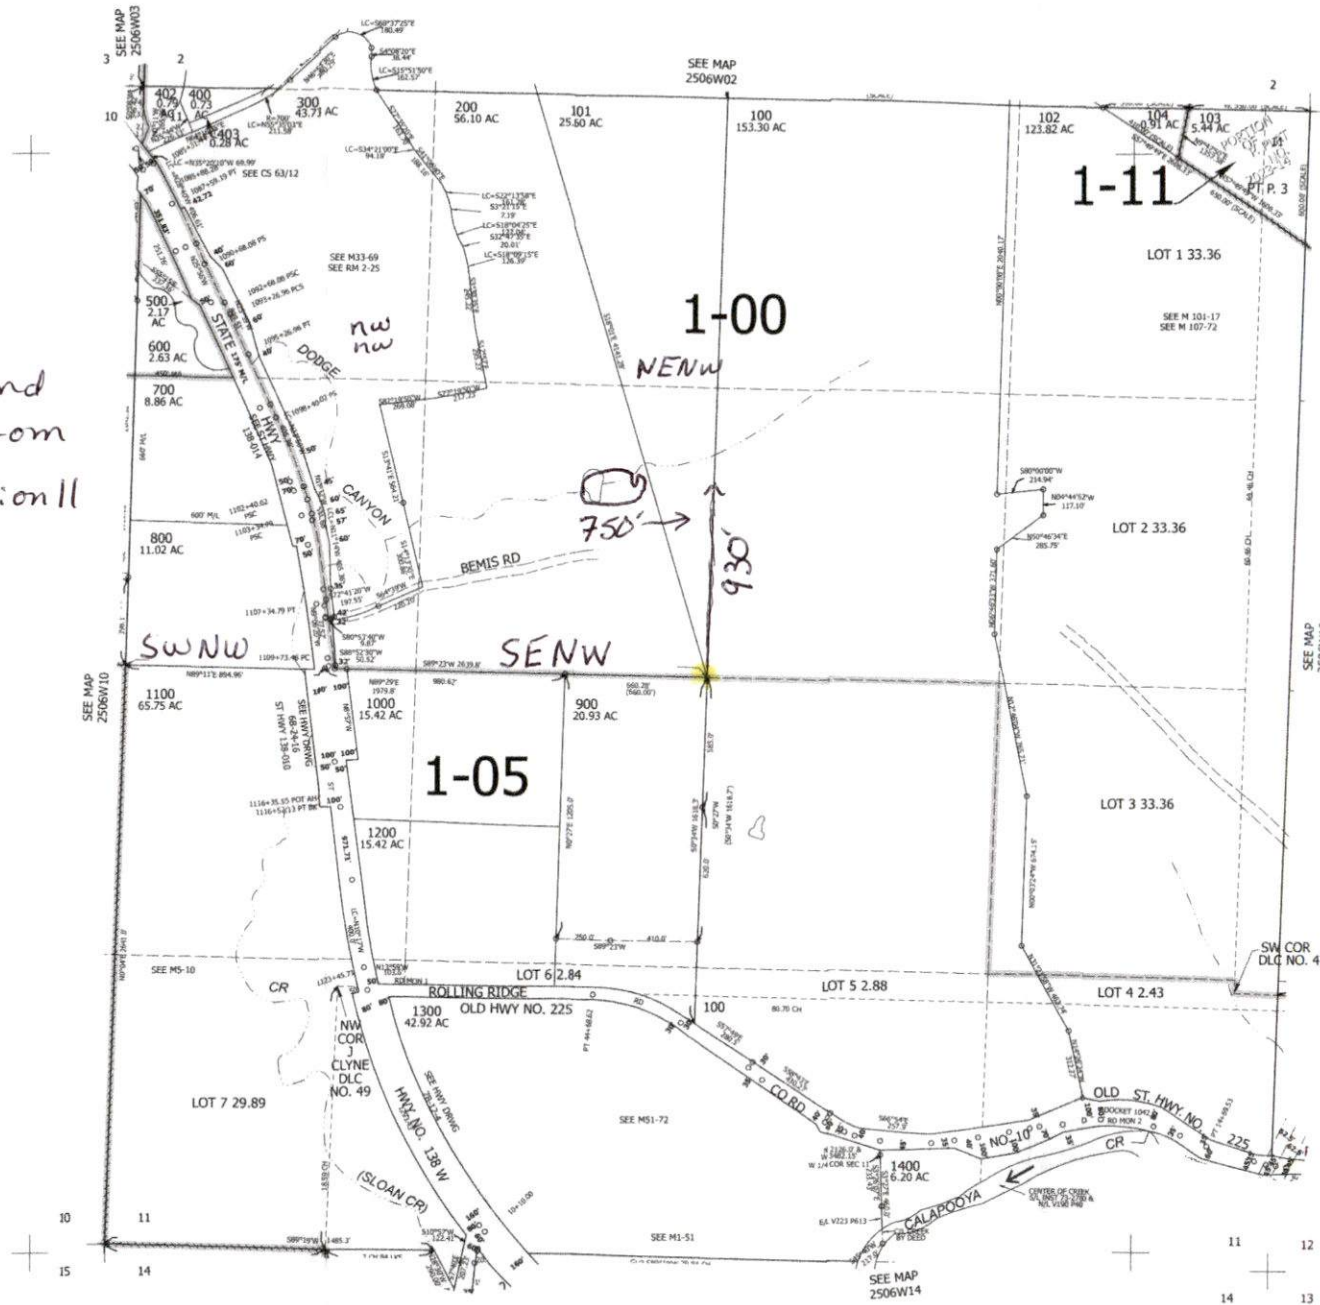

250611

Lower Right:
123°21'40"W 43°24'5"N
4161039E 645243N R