



Oregon Water Resources Department
725 Summer Street NE, Suite A
Salem, Oregon 97301
(503) 986-0900
www.oregon.gov/OWRD

Received

APR 24 2025

OWRD

Ownership Update for Certificated Rights Only

NO FEES ARE REQUIRED TO SUBMIT THIS FORM

NOTICE: A certificate of water right typically stays with the land. To track water right ownership, the Department requests that this form be submitted to the Department. **To update multiple rights, a separate form is required for each right.** If you have any questions about this form, please contact your local watermaster, or call the Water Resources Department at (503) 986-0900.

Note: Use the assignment form to change ownership on pending applications, permits, transfers, groundwater registrations, or limited licenses.

Current Landowner Information					
Name:	Edna A. Carr				
Mailing Address:	3404 SE Spring Dr				
City:	Hillsboro	State:	OR	Zip:	97123
Phone:	503-648-1782	Email:			

Property Information					
County:	WASHINGTON County	Township:	1N	Range:	4W
Tax Lot #:	1000	Section:	1		
Street Address of Water Right:	Forest Grove, Ore				
Water Right Information					
Application:					
Permit:	31838				
Certificate:					
Are all the lands associated with this water right owned by the requestor? <input type="checkbox"/> Yes <input checked="" type="checkbox"/> No					
(If no, include a map showing the portion of the water right involved)					


Signature and Date		
Name of individual completing form:	Edna Carr	
Phone or email:	503-648-1782	Date: 4/22/2025
Signature of requestor:	Edna Carr	

The Department does not change names on water right certificates. This form will be placed in the file for future reference only. If mailed, the Department will not provide acknowledgment of receipt.

This form can be mailed to the address above or sent by email to wrd_dl_customerservice@water.oregon.gov

Received
APR 24 2025
OWRD

T.1N.R.4W.W.M.

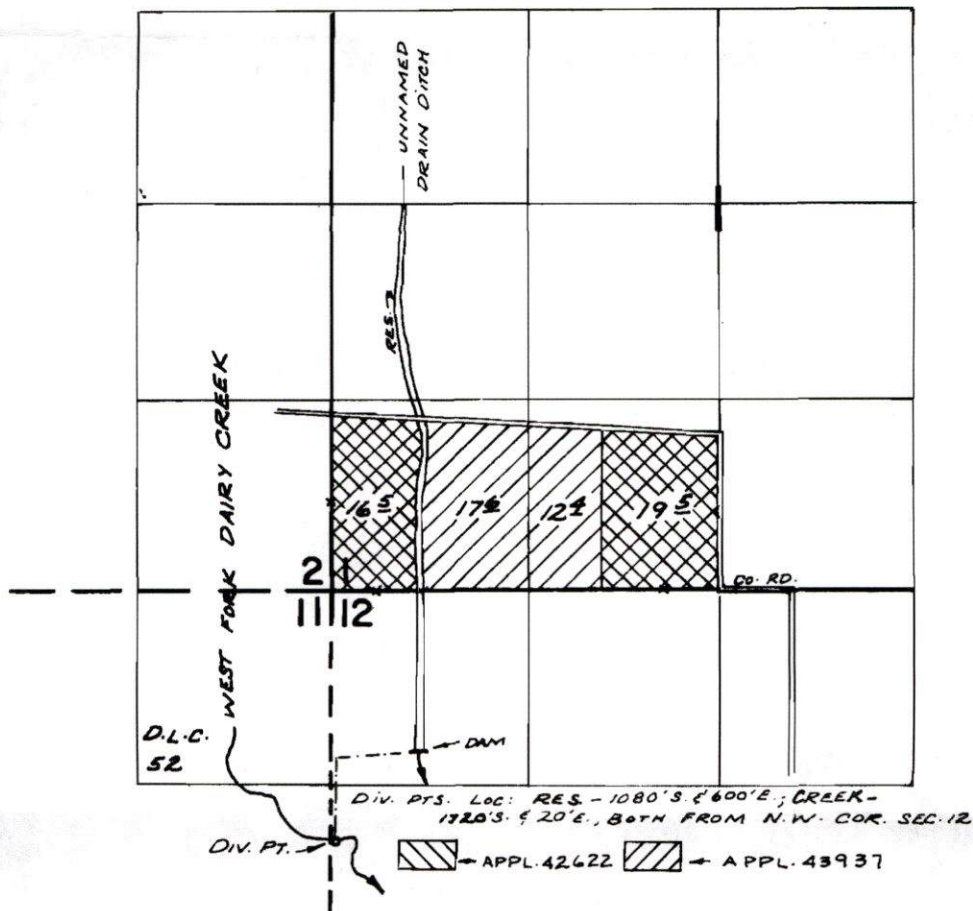

FINAL PROOF SURVEY UNDER

Application No. ⁴²⁶²²~~43936~~ Permit No. ³¹⁸³⁸~~R-5055~~
~~43937~~ ~~32830~~
IN NAME OF

ANTHONY P. HERB

Surveyed ~~JUNE 17~~ 19.71, by ~~R. MUCKEN~~

Received
APR 24 2025
OWRD

STATE OF OREGON
COUNTY OF WASHINGTON
CERTIFICATE OF WATER RIGHT

This Is to Certify, That ANTHONY P. HERB

of Route 2, Box 268, Forest Grove, State of Oregon, has made proof to the satisfaction of the STATE ENGINEER of Oregon, of a right to the use of the waters of an unnamed drainage ditch, reservoir, and West Fork Dairy Creek constructed under permit number R-1302, a tributary of Tualatin River for the purpose of irrigation of 36.0 acres

under Permit No. 31838 of the State Engineer, and that said right to the use of said waters has been perfected in accordance with the laws of Oregon; that the priority of the right hereby confirmed dates from August 11, 1966

that the amount of water to which such right is entitled and hereby confirmed, for the purposes aforesaid, is limited to an amount actually beneficially used for said purposes, and shall not exceed 0.45 cubic foot per second with any deficiency in the available supply from the drainage ditch to be made up by appropriation from West Fork Dairy Creek provided that the total quantity diverted from both sources shall not exceed 0.45 * or its equivalent in case of rotation, measured at the point of diversion from the stream.

The point of diversion is located in the NW $\frac{1}{4}$ NW $\frac{1}{4}$, SW $\frac{1}{4}$ NW $\frac{1}{4}$, Section 12, T. 1 N., R. 4 W., W. M., Reservoir - 1080 feet South and 600 feet East; Creek - 1720 feet South and 20 feet East; both from NW Corner, Section 12.

The amount of water used for irrigation, together with the amount secured under any other right existing for the same lands, shall be limited to one-eightieth of one cubic foot per second per acre, or its equivalent for each acre irrigated from direct flow and shall be further limited to a diversion of not to exceed 2 $\frac{1}{2}$ acre feet per acre for each acre irrigated during the irrigation season of each year from direct flow and storage from reservoir constructed under Permit No. R-1302,

and shall conform to such reasonable rotation system as may be ordered by the proper state officer.

A description of the place of use under the right hereby confirmed, and to which such right is appurtenant, is as follows:

16.5 acres SW $\frac{1}{4}$ SW $\frac{1}{4}$
19.5 acres SE $\frac{1}{4}$ SW $\frac{1}{4}$
Section 1
T. 1 N., R. 4 W., W. M.

* cubic foot per second.

The right to the use of the water for the purposes aforesaid is restricted to the lands or place of use herein described.

WITNESS the signature of the State Engineer, affixed

this date. December 14, 1972

CHRIS L. WHEELER

State Engineer