

18487 S. Valley Vista Rd.
Mulino, Oregon 97042
(503) 632-5016 Phone
(503) 632-5983 Fax

Pacific Hydro-Geology Inc.

E-RECEIVED

MAY 12 2025

OWRD

Memo

To: Oregon Water Resources Department / Lucinda Vranizan
From: Doann Hamilton, CWRE
CC:
Date: May 12, 2025
Re: Application G-19402 revisions (updated)

On April 25, 2025 our client Jason Kraxberger received the Initial Review (IR) for his water right Application G-19402 to approve with additional information required:

1. Map needs revised showing the mainlines
2. The Department needs written authorization or an easement permitting access to lands not owned by the applicant

Jason has mailed to OWRD:

1. Written consent letter for TL 4 1E 23 700
2. And he has mailed the recording fee of \$610

The map revisions showing the proposed and buried mainlines, is attached.



Please let us know you have received and have enough information to review and proceed.



MAY 12 2025

OWRD

T.4S. R.1E. Section 23, W.M.

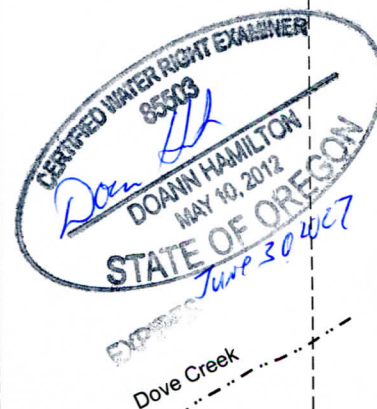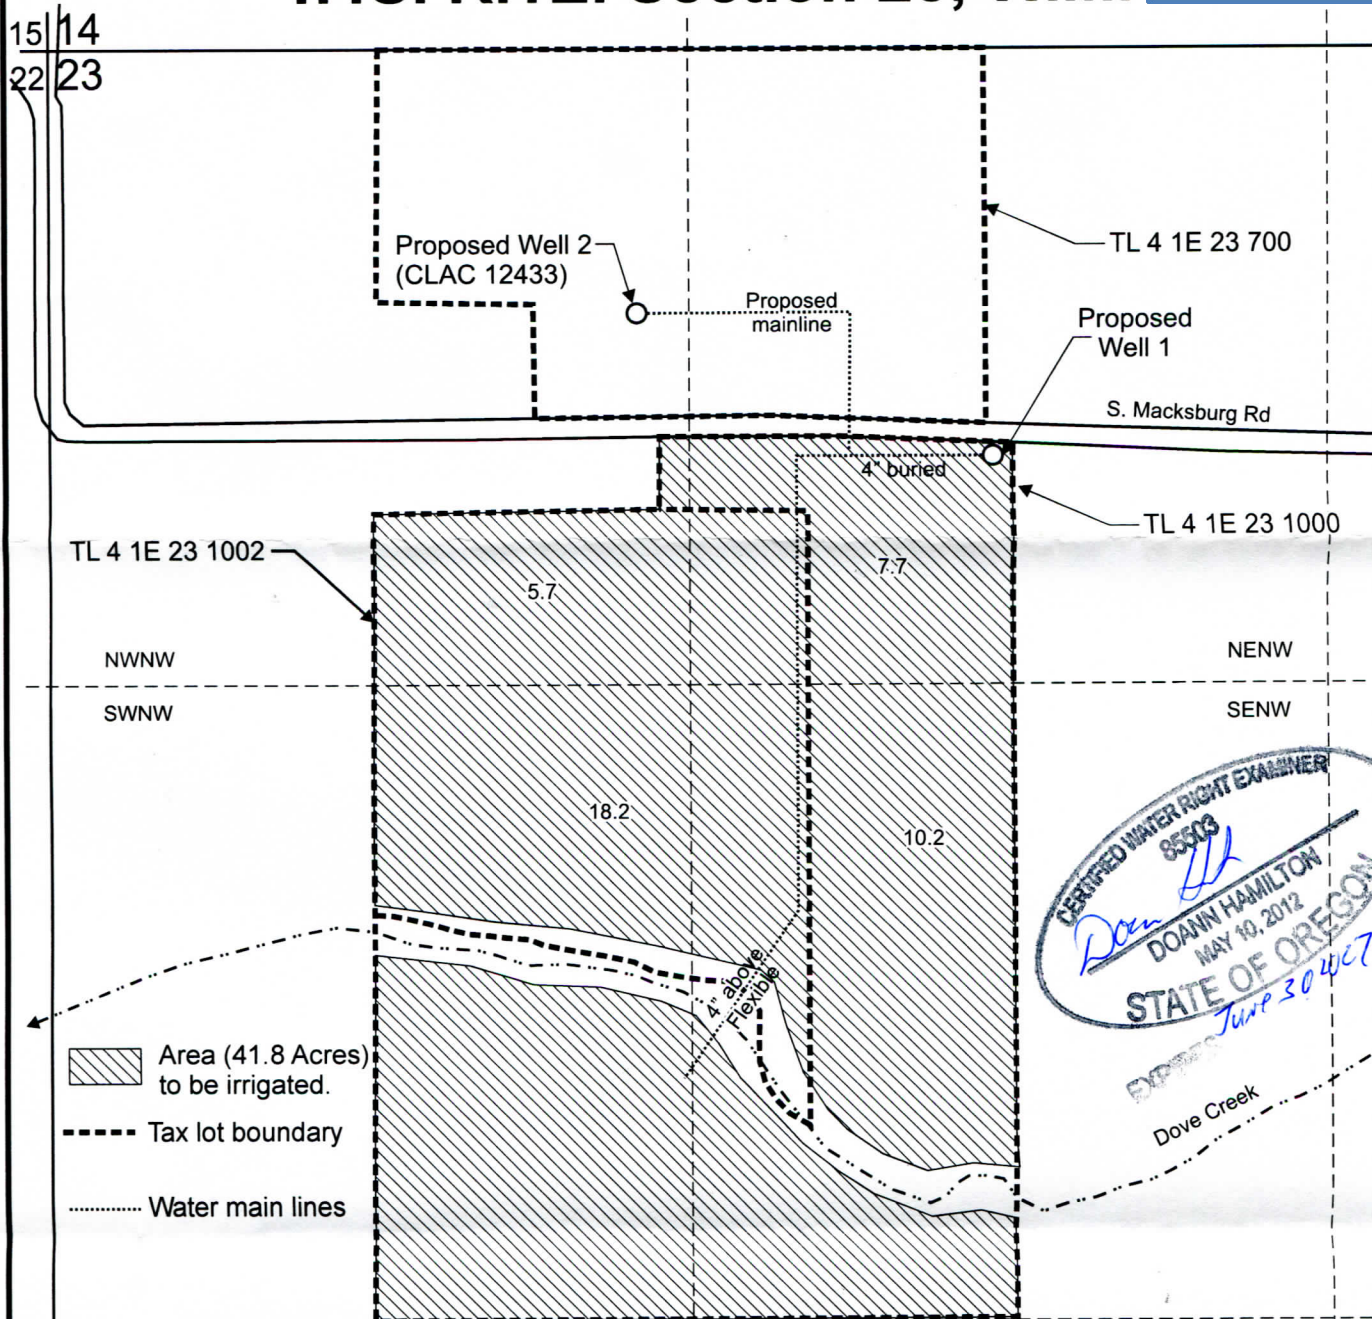

Proposed Well 1 is located 850 feet south and 1,955 feet east from the NW corner, Section 23.

Proposed Well 2 (CLAC 12433) is located 550 feet south and 1,220 feet east from the NW corner, Section 23.

Scale: 1" = 400'



This map was prepared for the purpose of identifying the location of a water right only and is not intended to provide legal dimensions or location of property ownership lines.

Water Right Application Map

Pacific Hydro-Geology Inc.

10/2023
Rev. 05/2025

Jason Kraxberger
T.4S. R.1E. Section 23, W.M.