

RECEIVED

DEC 08 1998


WATER RESOURCES DEPT.
SALEM, OREGON

APPLICATION MAP
IN THE NAME OF WESTBROOK LAND AND TIMBER, L.L.C.
SECTIONS 4 & 9, TOWNSHIP 27, SOUTH, RANGE 14 WEST, W.M.


RECEIVED

DEC 30 1997

WATER RESOURCES DEPT.
SALEM, OREGON

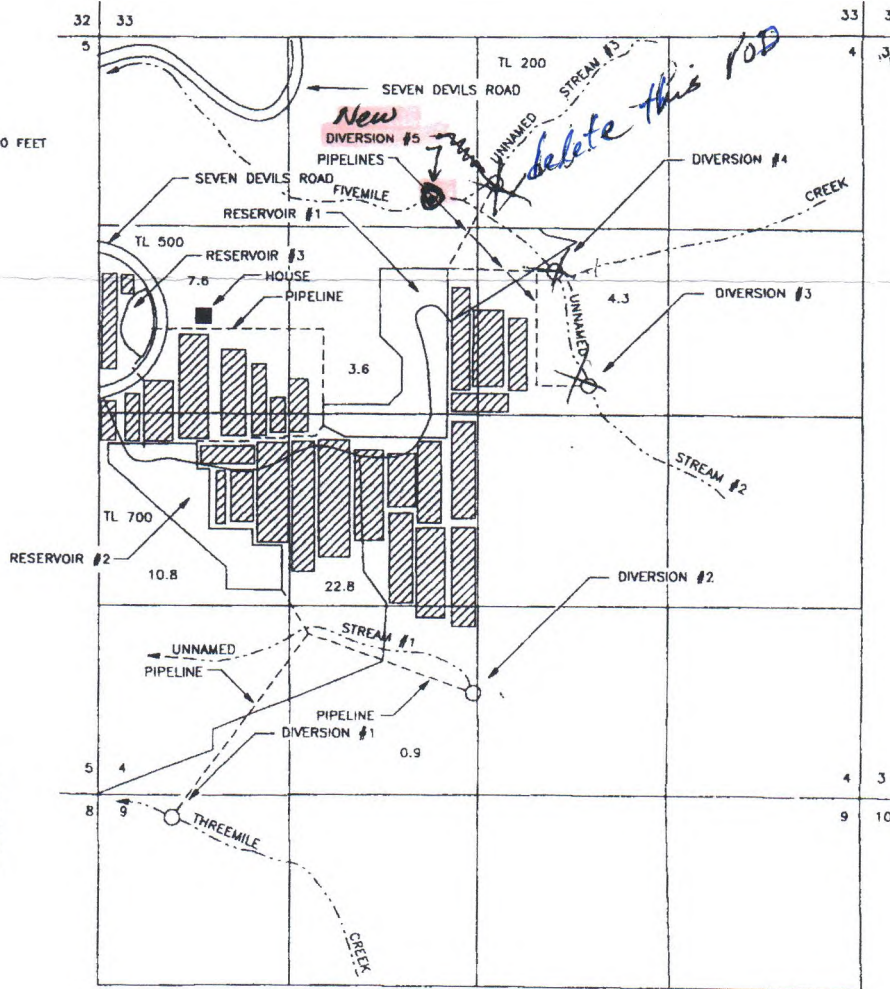

DRWG. 97-104

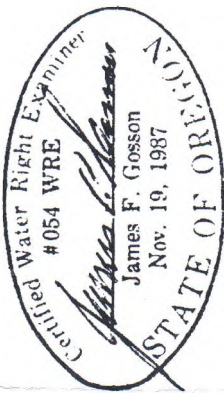

DIVERSION	FT. N/S	FT. E/W	FROM	LOCATION	SECTION
#1	140' S	520' E	SW COR. S4	NW1/4 NW1/4	9
#2	720' N	2600' E	SW COR. S4	SE1/4 SW1/4	4
#3	2820' N	3380' E	SW COR. S4	SW1/4 NE1/4	4
#4	3610' N	3160' E	SW COR. S4	SW1/4 NE1/4	4
#5	4100' N 4210' N	2320' E 2740' E	SW COR. S4	NE NW1/4 NE1/4	4

ALL WITHIN TOWNSHIP 27 SOUTH, RANGE 14 WEST, W.M., COOS COUNTY, OREGON.
THE PURPOSE OF THIS MAP IS TO IDENTIFY THE LOCATION OF THE WATER RIGHT. IT IS NOT INTENDED TO PROVIDE INFORMATION RELATIVE TO THE LOCATION OF PROPERTY OWNERSHIP BOUNDARY LINES.

83741

53529