

Received
MAY 12 2025

OWRD

26 3 29
& INDEX

THIS MAP WAS PREPARED FOR
ASSESSMENT PURPOSE ONLY.

SEC.29 T.26S. R.3W. W.M.
DOUGLAS COUNTY
1" = 400'

REVISED ON
1-11-18

SEE MAP 26 3 29

CANCELLED NOS

SEE MAP 26 3 28

PARCEL 400
1. 57°17'17" 143.9'
2. 56°53'32" 266.9'
3. 57°15'51" 217.8'
4. 50°49'41" 207.8'
5. 58°39'01" 210.3'
6. 56°22'21" 158.5'
7. 57°14'30" 215'
8. 58°44'42" 152.8'
9. 58°11'17" 213.9'

SEE MAP 26 3 30

SEE MAP

26 3 29C

SEE MAP 26 3 32

SEE MAP 26 3 32A

PARCEL 1200
1. N89°10'38"E 141.7'
2. N25°14'40"E 102.9'
3. N34°53'51"E 88.48'
4. N10°16'27"E 87.34'
5. N39°14'00"E 113.40'
6. N35°14'00"E 105.58'
7. S84°30'56"E 138'
8. S87°08'56"E 103.31'
9. S87°09'56"E 112.89'
10. S71°14'56"E 82'
11. S52°20'56"E 45.53'
12. N59°25'32"E 110.74'

596,000

26 3 29
& INDEX

#6 = 150' south + 1200' west from E 1/4 corner
of section 29

Received
FFR 28 2025

OWRD

Received
MAR 17 2025

OWRD

Received by OWRD

MAR 24 2025

Salem, OR

Received

MAR 17 2025

OWRD

Received

FEB 28 2025

OWRD

Received

2025

OWRD

THIS MAP WAS PREPARED FOR
ASSESSMENT PURPOSE ONLY.


SEC. 28 T. 26S. R. 3W. W.M.
DOUGLAS COUNTY
1" = 400'

REVISED ON
7-9-16

26 3 28

Received
MAY 12 2025

OWRD

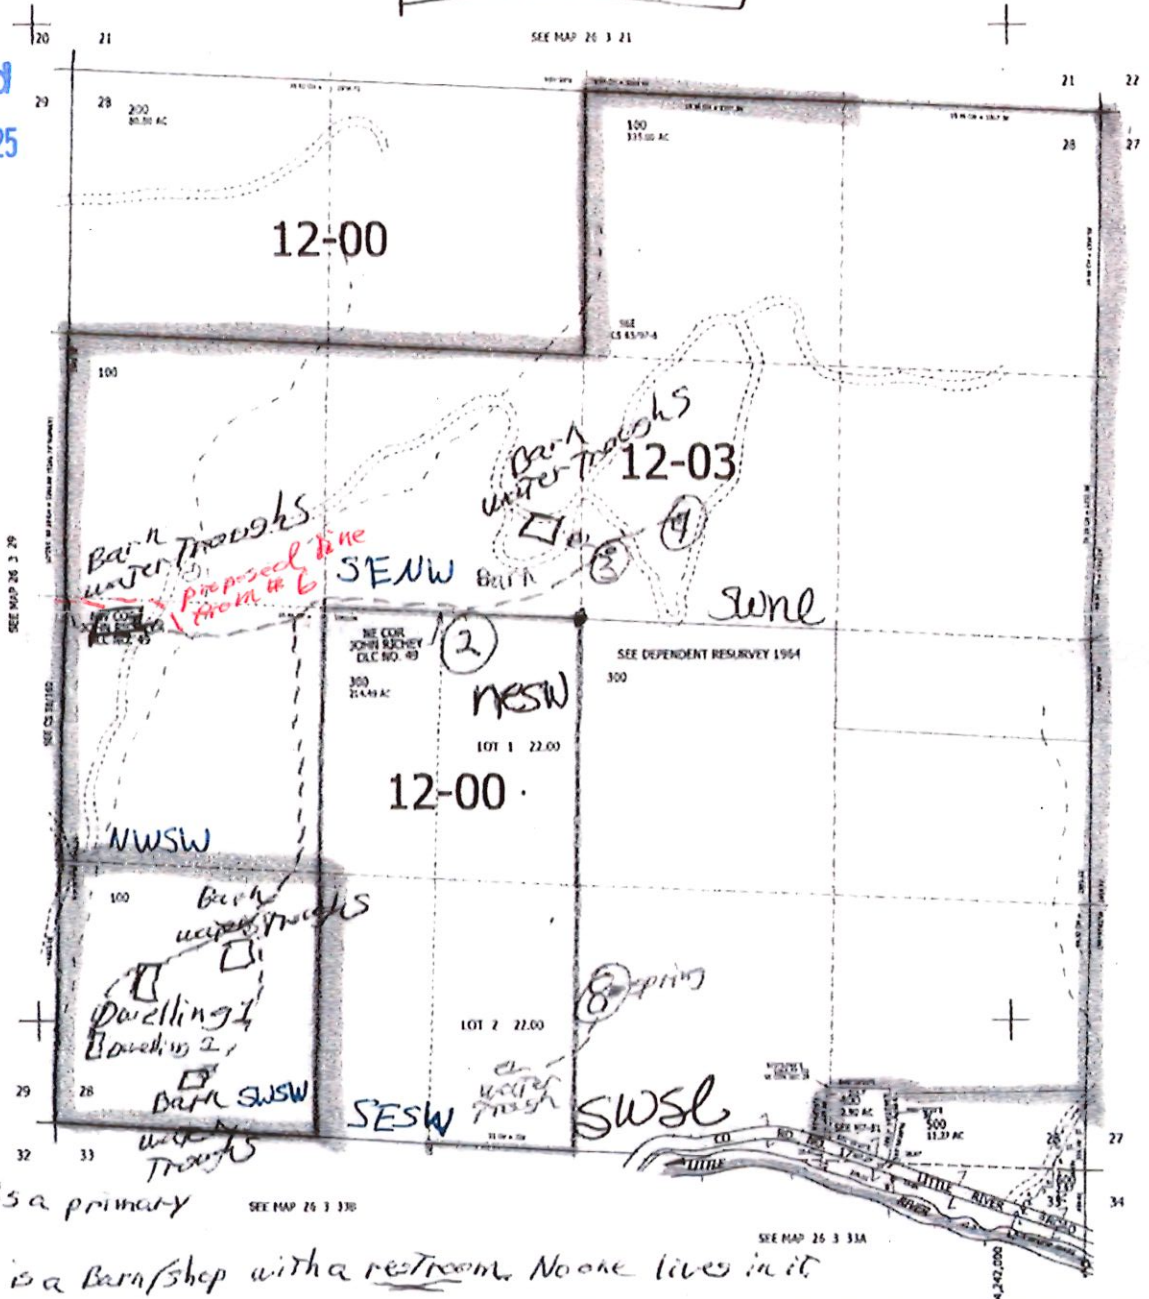

Dwelling 1 is a primary residence

Dwelling 2 is a Barn/shop with a restroom. No one lives in it

- #2 = 200' South + 600' W from center of section 28
#3 = 100' north + 100' E from center of section 28
#4 = 250' north + 400' E from center of section 28
#8 = 1980' south + 100' E from center of section 28
--- 3/4 poly pipe existing or proposed

26 3 28