

Application to Store Water - Reservoir

Sunset Farm JC, LLC


Township 16 S. Range 5 W., W.M. NW NE, Section 1, TL 700

RECEIVED

FEB 19 2021

OWRD

Existing
Pond
location

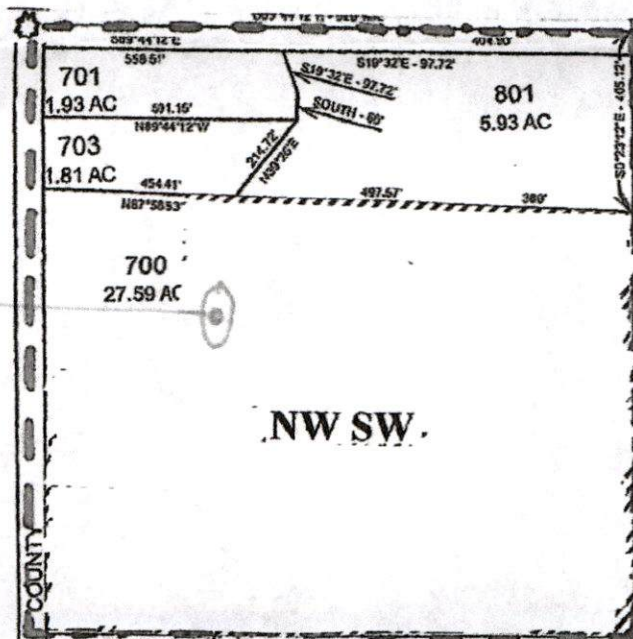

Received

MAY 16 2025

OWRD

367 Feet East and 600 Feet South, from the Reference Corner

☼ Reference Corner: Center $\frac{1}{4}$ Corner of Section 1, T.16 S., R. 5 W.