


Claim of Beneficial Use

Permit R-14883, Application R-87488

A Water Right held by Aldevale Properties LLC
Clackamas County

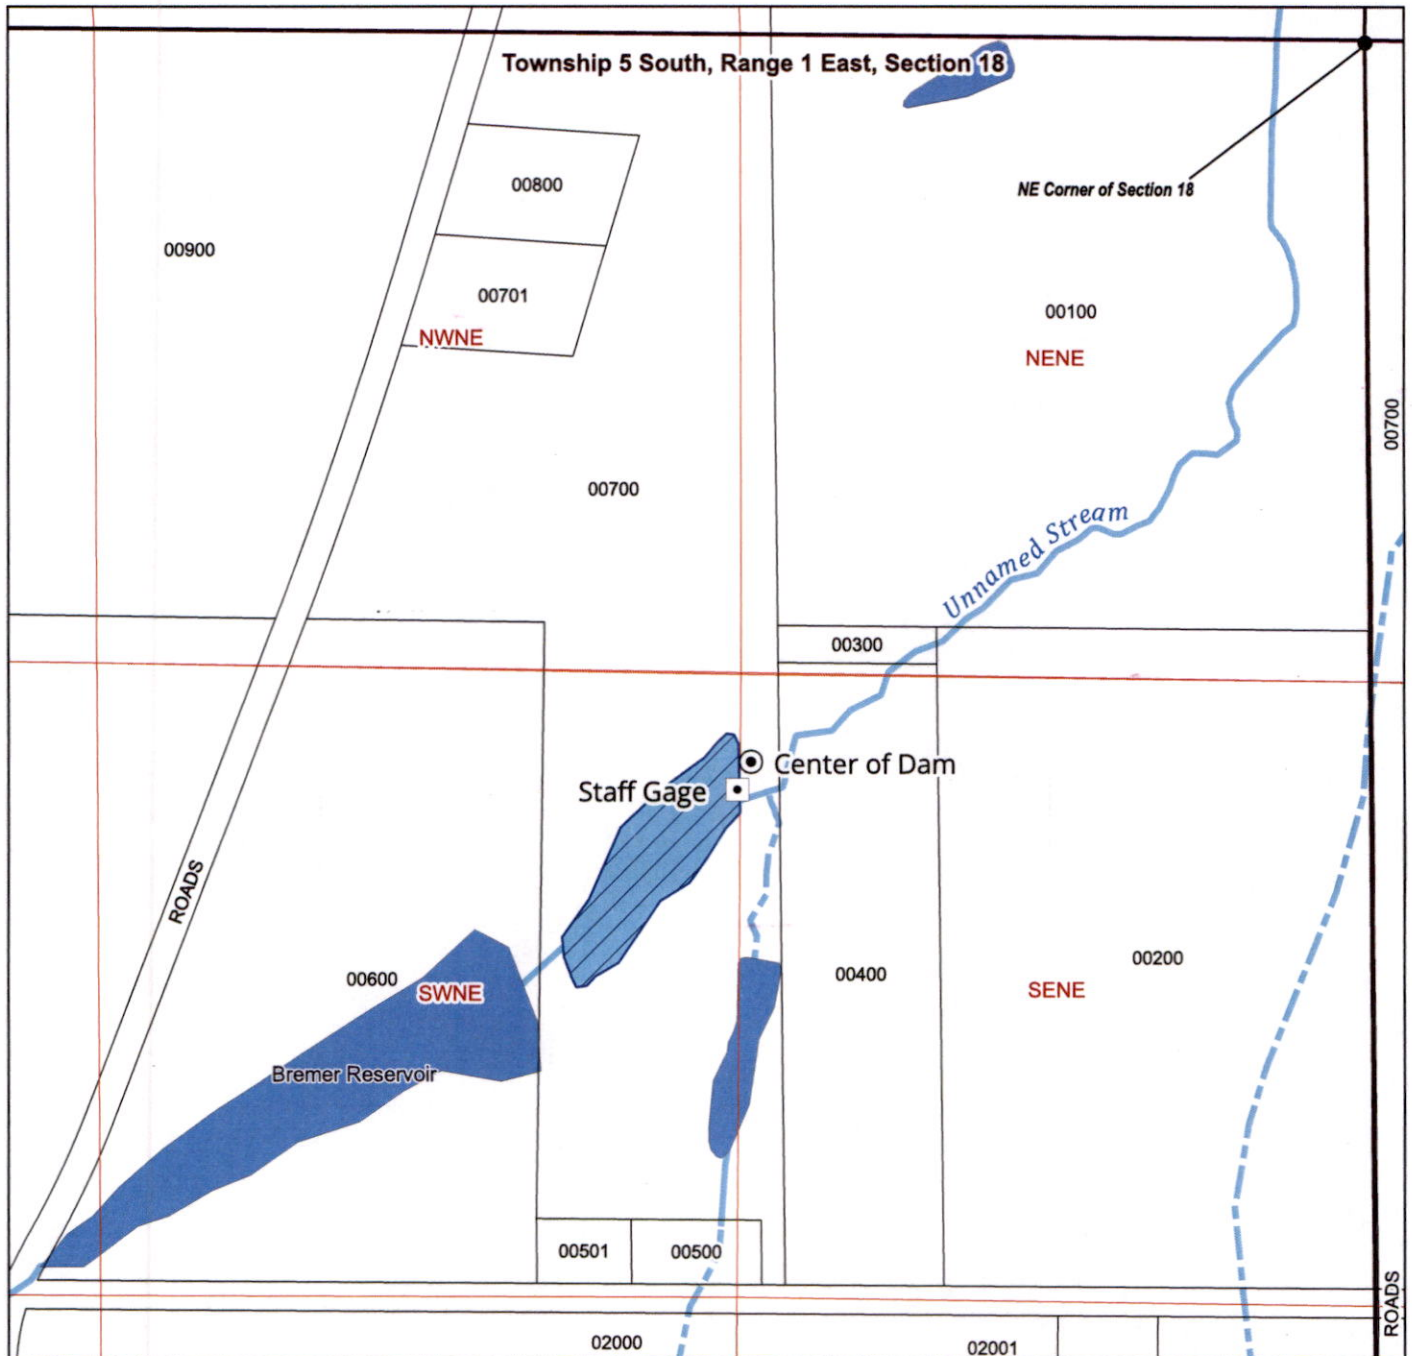

LEGEND

- Point of Diversion (POD)
- Staff Gage
- ▨ Place of Use (POU)
- Perennial Watercourse
- - - Intermittent Watercourse
- Tax Lots
- Waterbody

POD Location Description

Center of Dam
Located 1470 feet South and
1270 feet West from NE corner
of Section 18, Township 5 South,
Range 1 East, W.M.

Received
MAY 19 2025

OWRD

Date: 5/1/2025
Data Sources: BLM, OWRD, ODFW, USGS, Clackamas County.
Disclaimer: This map is not intended to provide legal dimensions
or property ownership lines.

