


INDUSTRIAL USE MAP OF STORED WATER  
 USE AREA T32S R15W  
 SECTION 7; SWNE, SENE, NESE  
 NWSE 1/4 1/4'S

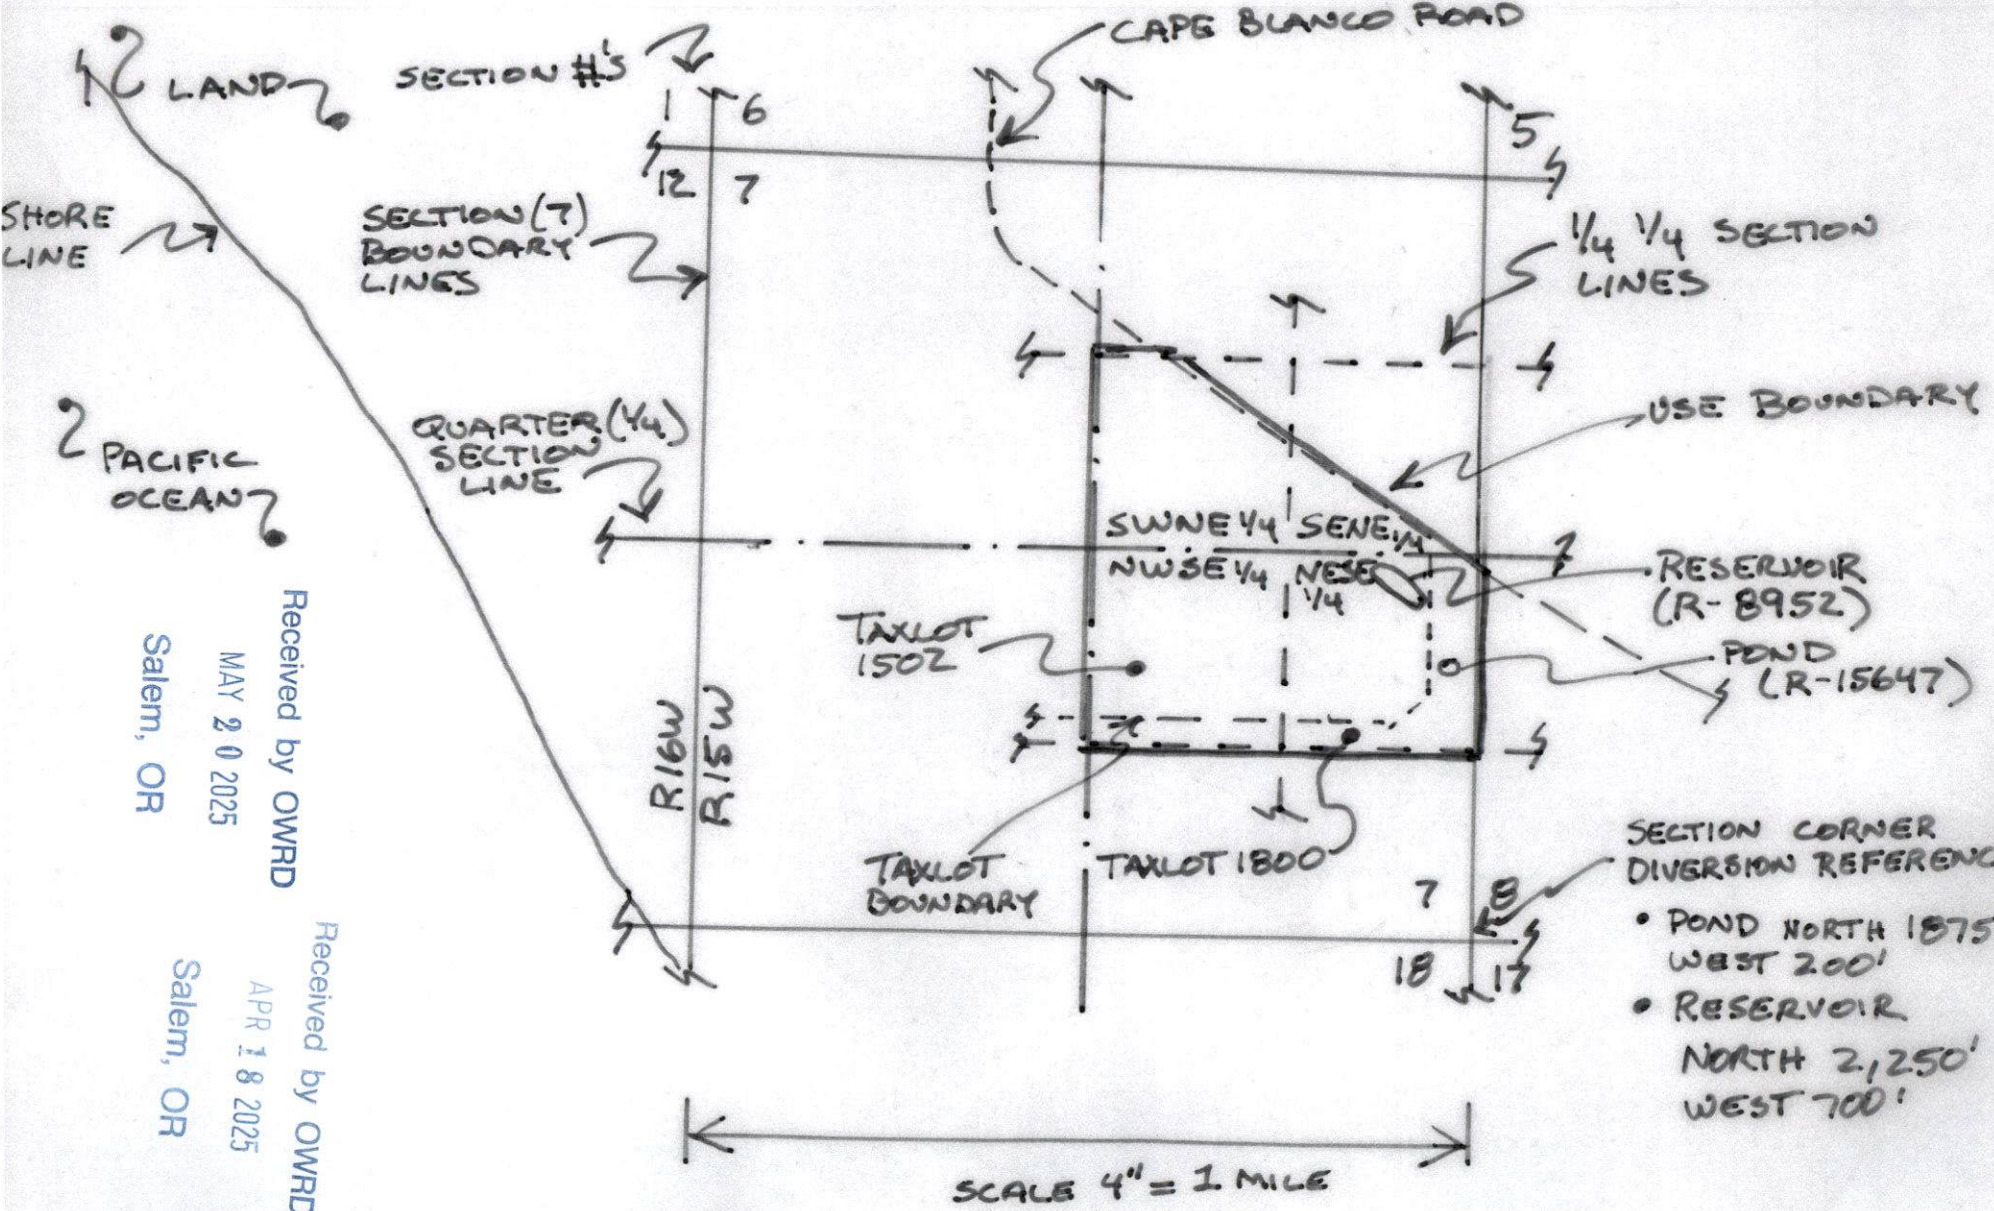

- SECTION CORNER  
 DIVERSION REFERENCE:
- POND NORTH 1875'  
 WEST 200'
  - RESERVOIR  
 NORTH 2,250'  
 WEST 700'

Received by OWRD  
 MAY 20 2025  
 Salem, OR

Received by OWRD  
 APR 18 2025  
 Salem, OR

TOM GRUSZCZENSKI, CWRE 4/10/2025