



LEGEND


- | | |
|---|---|
| <ul style="list-style-type: none"> ⊙ Authorized Point of Appropriation (POA) M Meter ■ Authorized Place of Use (POU) | All Other Features <ul style="list-style-type: none"> □ Tax Lot □ Government Lot (GL) □ Donation Land Survey (DLC) |
|---|---|

Claim of Beneficial Use Map City of Scappoose Place of Use/Points of Appropriation

T-14318

Township 3 North, Range 2 West (W.M.)

CERTIFIED WATER RIGHTS EXAMINER STAMP

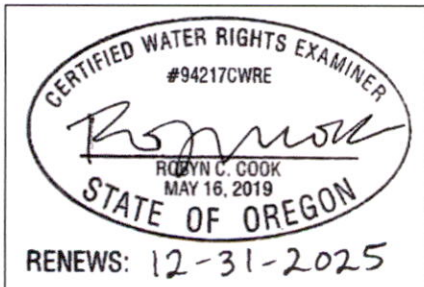

Received

MAY 21 2025

OWRD

LOCATION DESCRIPTION

Dutch Canyon 1 (DC-1)

Located 1,465 feet North and 1,815 feet East from the SW corner of Section 13, Township 3 North, Range 2 West (W.M.)

Dutch Canyon 2 (DC-2)

Located 1,455 feet North and 1,895 feet East from the SW corner of Section 13, Township 3 North, Range 2 West (W.M.)

DC-3

Located 1,425 feet North and 1,855 feet East from the SW corner of Section 13, Township 3 North, Range 2 West (W.M.)

DISCLAIMER

This map was prepared for the purpose of identifying the location of a water right only and it is not intended to provide legal dimensions or location of property ownership lines.

Date: May 15, 2025

Data Sources: BLM, ESRI, OWRD, USGS

