


● GUADALUPE SPRING
 131' S 112' W FROM NE CORNER DLC 37
 □ S-53988 POU
 ON LOT 40
 ▲ TANKS and METER
 ◇ S-59389 POU ON LOT 40 S15 T48N R7W

DOMESTIC USE
 CLAIMS OF BENEFICIAL USE
 APPLICATION S-84817 APPLICATION S-85127
 PERMIT S-53988 PERMIT S-53989

LACANA FAMILY TRUST
 327 SALU RD
 WAILUKU, HI 96793

CERTIFIED WATER RIGHT EXAMINER
 91298CWRE
Richard F. Parsons
 RICHARD F. PARSONS
 JULY 10, 2018
 STATE OF OREGON

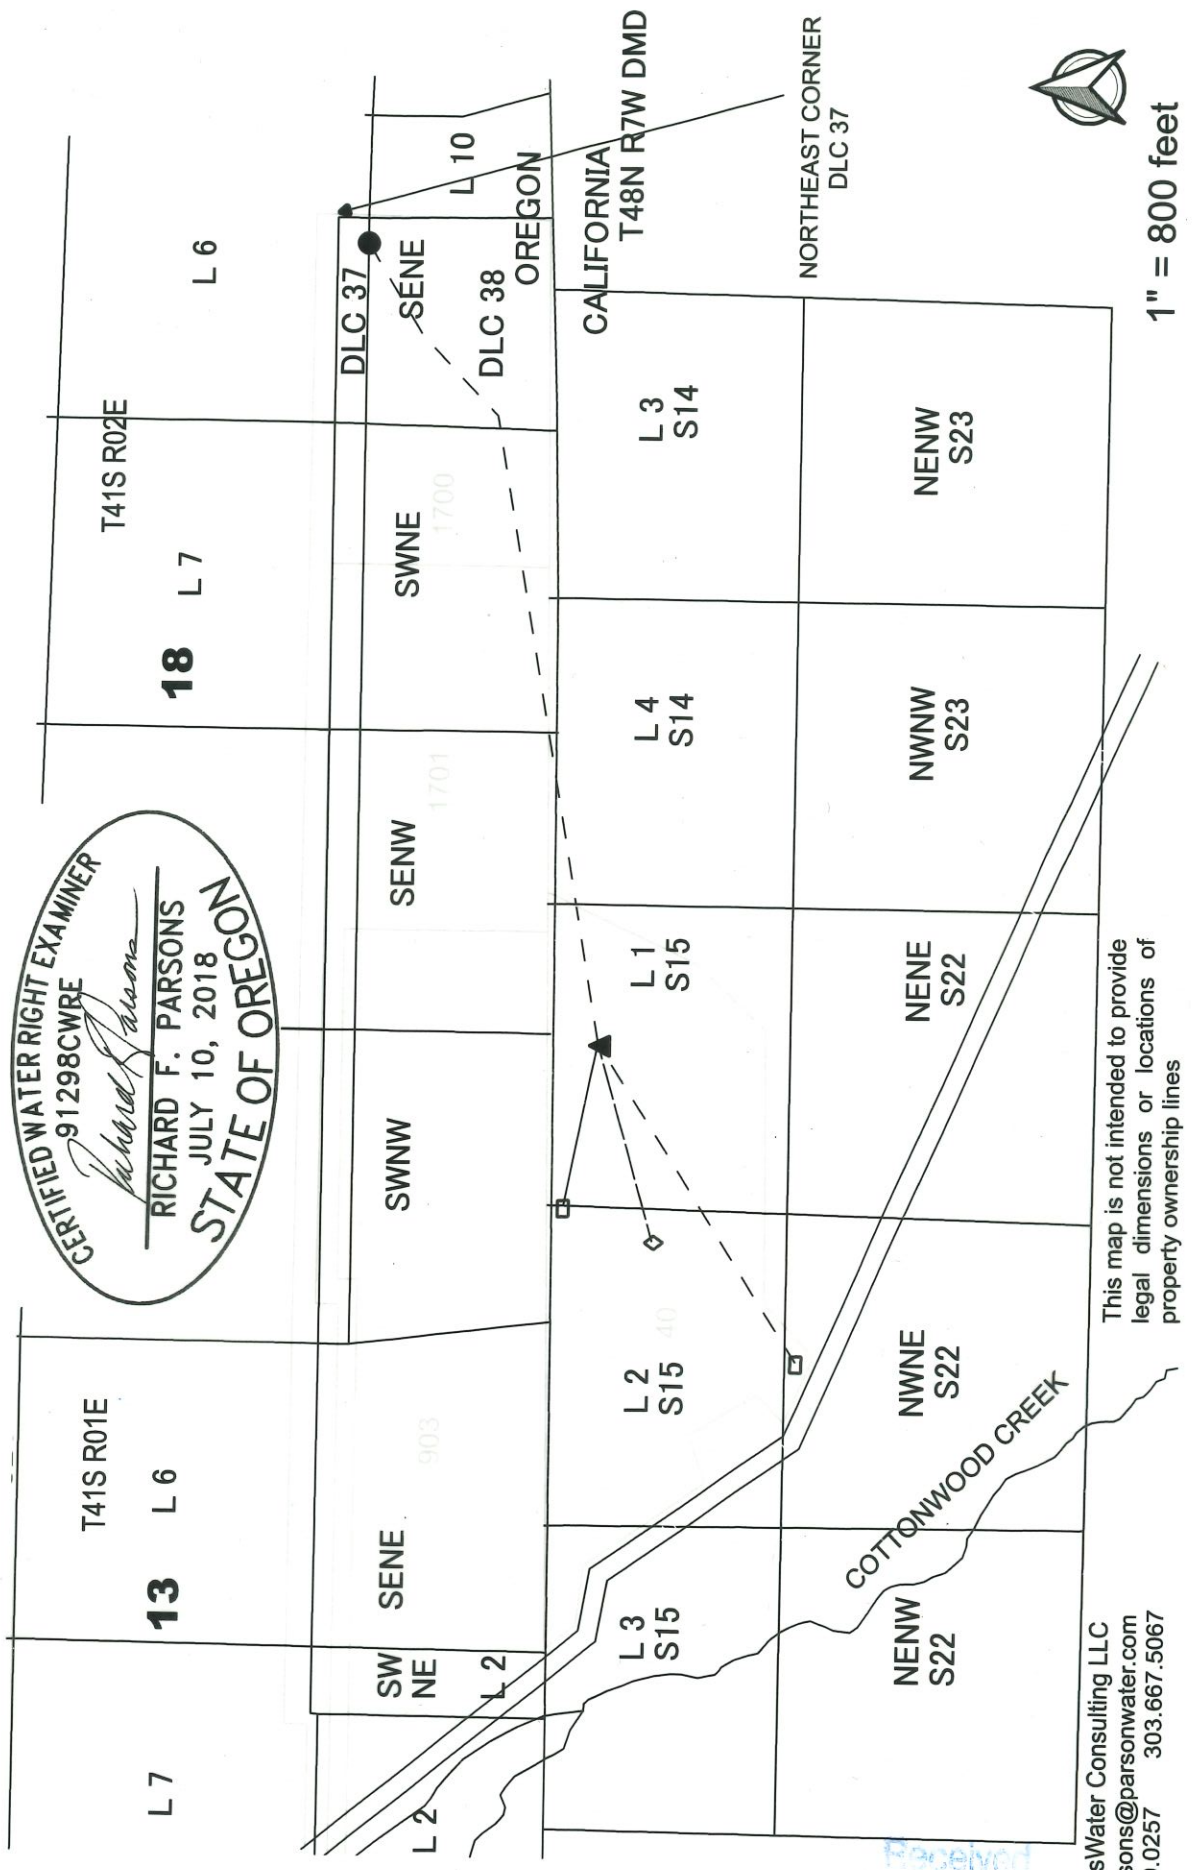

This map is not intended to provide
 legal dimensions or locations of
 property ownership lines

ParsonsWater Consulting LLC
 rick.parsons@parsonswater.com
 541.499.0257 303.667.5067