

T2S, R33E, Sections 17-18  
App. G-12832 / Permit G-12242

POA-1 (Well-2)  
651 ft S and 4,881 ft W  
from NE Corner, Sec 17  
(meter at wellhead)

Reference  
Corner

East Birch Creek

3.0 ac

1.6 ac

3.2 ac

4.9 ac

4.2 ac

Received  
MAY 23 2025  
OWRD

Received  
MAY 23 2025  
OWRD

Sec-18

1604

Sec-17

1600

1605

#### Acreage by Taxlot:

1604: 4.6 ac  
1600: 12.3 ac

Acreages by QQ are  
displayed on map.


This map is not intended to provide legal dimensions  
or locations of property ownership lines.



311 B Avenue, Suite P  
Lake Oswego, Oregon 97034  
(503) 954-1326

Figure 1  
Amended Claim of Beneficial Use Map  
for Permit G-12242

| 1   | DATE | AUTH | DRAFT     |
|-----|------|------|-----------|
|     |      |      |           |
|     |      |      |           |
| No. | Date | By   | Revisions |

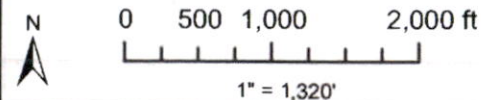

Proj#: 2413001  
Miller Valley  
Mike Miller  
3330 Hayden Bridge Road  
Springfield, OR 97477

- G-12242 POA (Well-2)
- Amended G-12242 POU
- Taxlots
- Approx Distribution Lines