



Claim of Beneficial Use

FOR: ERIC SCHWARTZ
BY: NATHAN REED, PE, CWRE
T30S, R6W, W.M. SECTION 1
APPLICATION No.: S-73112
PERMIT No.: S-51706

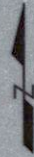

DATE OF SURVEY: OCTOBER 25, 2024

SCALE: 1" = 1320'

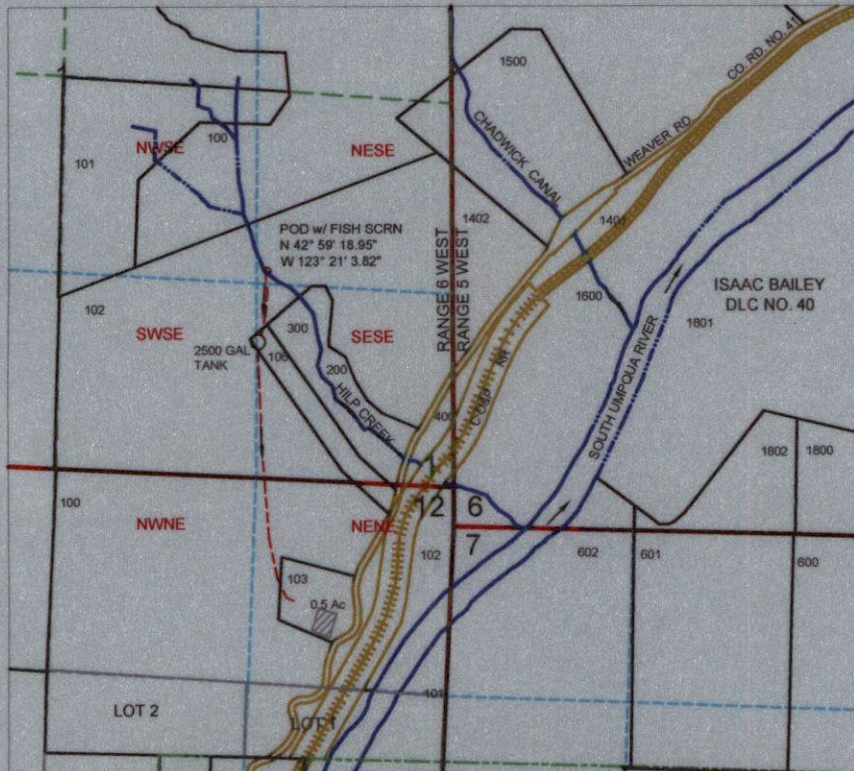


Received
MAY 27 2025

OWRD







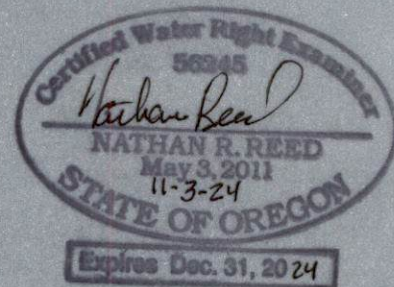



Received
JAN 27 2025

OWRD

POD IS LOCATED 1398 FEET NORTH & 1263 FEET WEST OF SE CORNER OF SECTION 1.



LEGEND

	WATER		SECTION
	POD		QUARTER
	PIPE		SIXTEENTH
	PARCEL		DLC
			GLOT
			IRRIGATION AREA

MAP PREPARED FOR:
ERIC SCHWARTZ
16747 ARMSTRONG WOODS ROAD
GERENVILLE, CA 95446

MAP PREPARED BY:
NATHAN REED PE, CWRE
157 WEST BODIE STREET
ROSEBURG, OR 97471

THE PURPOSE OF THIS MAP IS TO IDENTIFY THE LOCATION OF THE WATER RIGHT. IT IS NOT INTENDED TO PROVIDE INFORMATION RELATIVE TO THE LOCATION OF PROPERTY OWNERSHIP BOUNDARY LINES.