


SECTION 7, T38S, R02W, WM -- JACKSON COUNTY

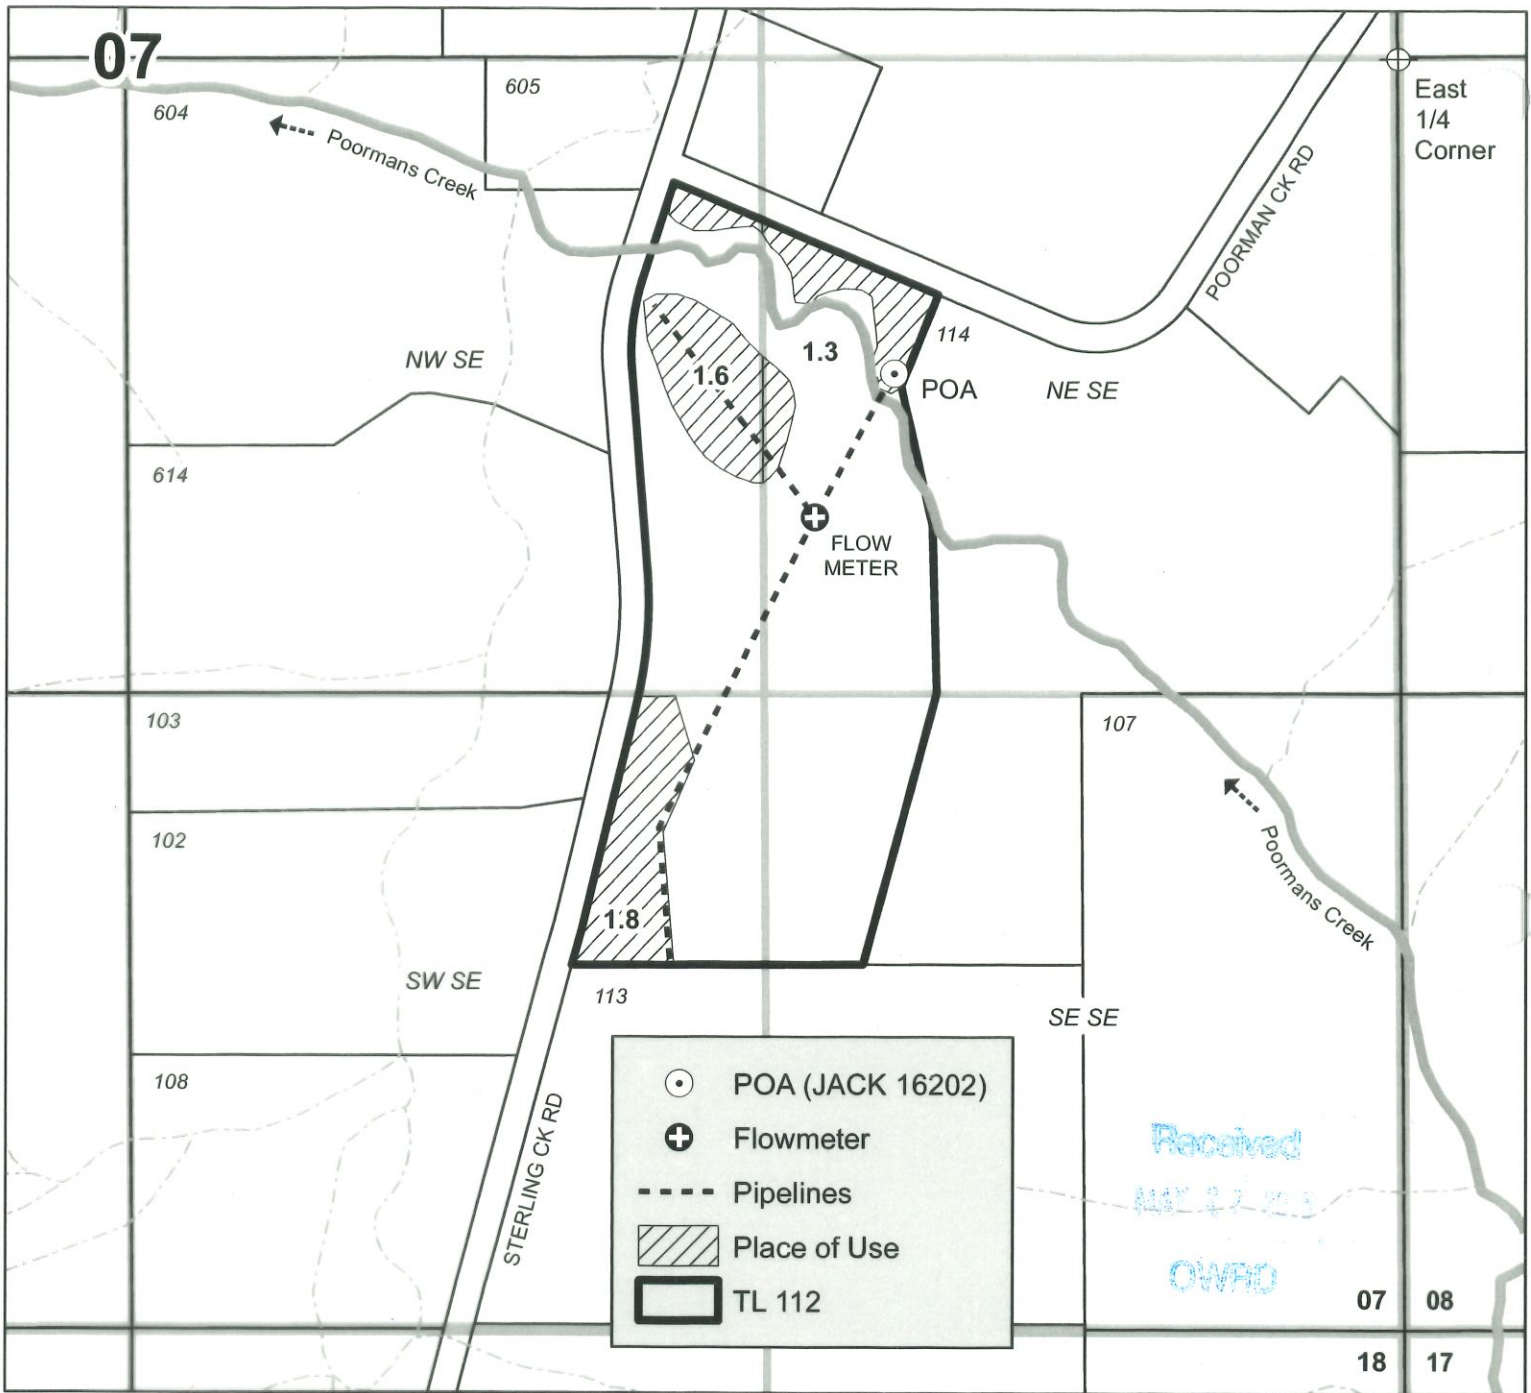

AUTHORIZED POA


Groundwater well described by Well Tag L94554 and Well Log JACK 16202. Located in NE SE, Sec 07, T38S, R02W, WM, about 660 ft S and 1060 ft W from East 1/4 Corner of Sec 07.

WATERSOLVING, LLC
John Warinner, PE, CWRE
johnw@watersolving.com
541.815.4103 mobile

DISCLAIMER
This map is not intended to provide legal dimensions or locations of property ownership lines.



1 in = 400 ft

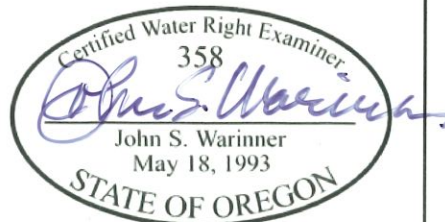

CLAIM OF BENEFICIAL USE MAP
Permit G-15968

BRANDY DESIMONE
JOSEPH DESIMONE

Revised 2024-03-28