


T.2S. R.4W. Section 19, and T.2S. R.5W. Section 24, W.M.

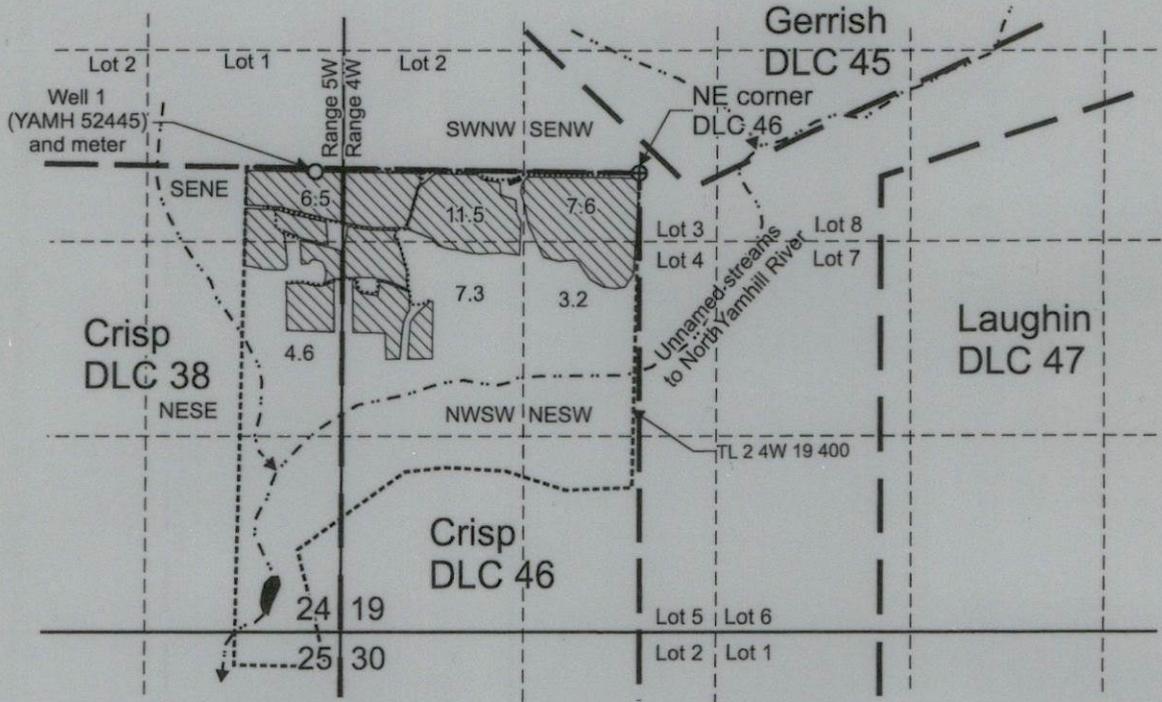

Well 1 (YAMH 52445) is located 36 feet south and 2,165 feet west from the NE corner, DLC 46.

 Area (40.7 Acres) irrigated under Application G-15131, Permit G-13909.

----- Tax lot boundary

— . Donation Land Claim boundary

..... Water main line


Received

JUN 05 2025

OWRD



Scale: 1" = 1,320'

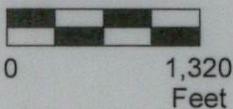

This map was prepared for the purpose of identifying the location of a water right only and is not intended to provide legal dimensions or location of property ownership lines.



Claim of Beneficial Use Map
Application G-15131, Permit G-13909

Pacific Hydro-Geology Inc.

Lazy River Vineyard LLC
T.2S. R.4W. Section 19 and
T.2S. R.5W. Section 24 W.M.

05/2025