
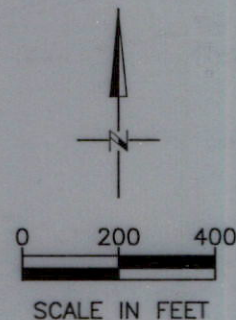


COBU MAP FOR APPLICATION G-16210, PERMIT G-15773  
IN THE NAME OF AUSTIN D. BAUMGARDNER  
SEC 7 & 18, T5N, R36E, W.M., UMATILLA COUNTY

Received  
JUN 06 2025

OWRD

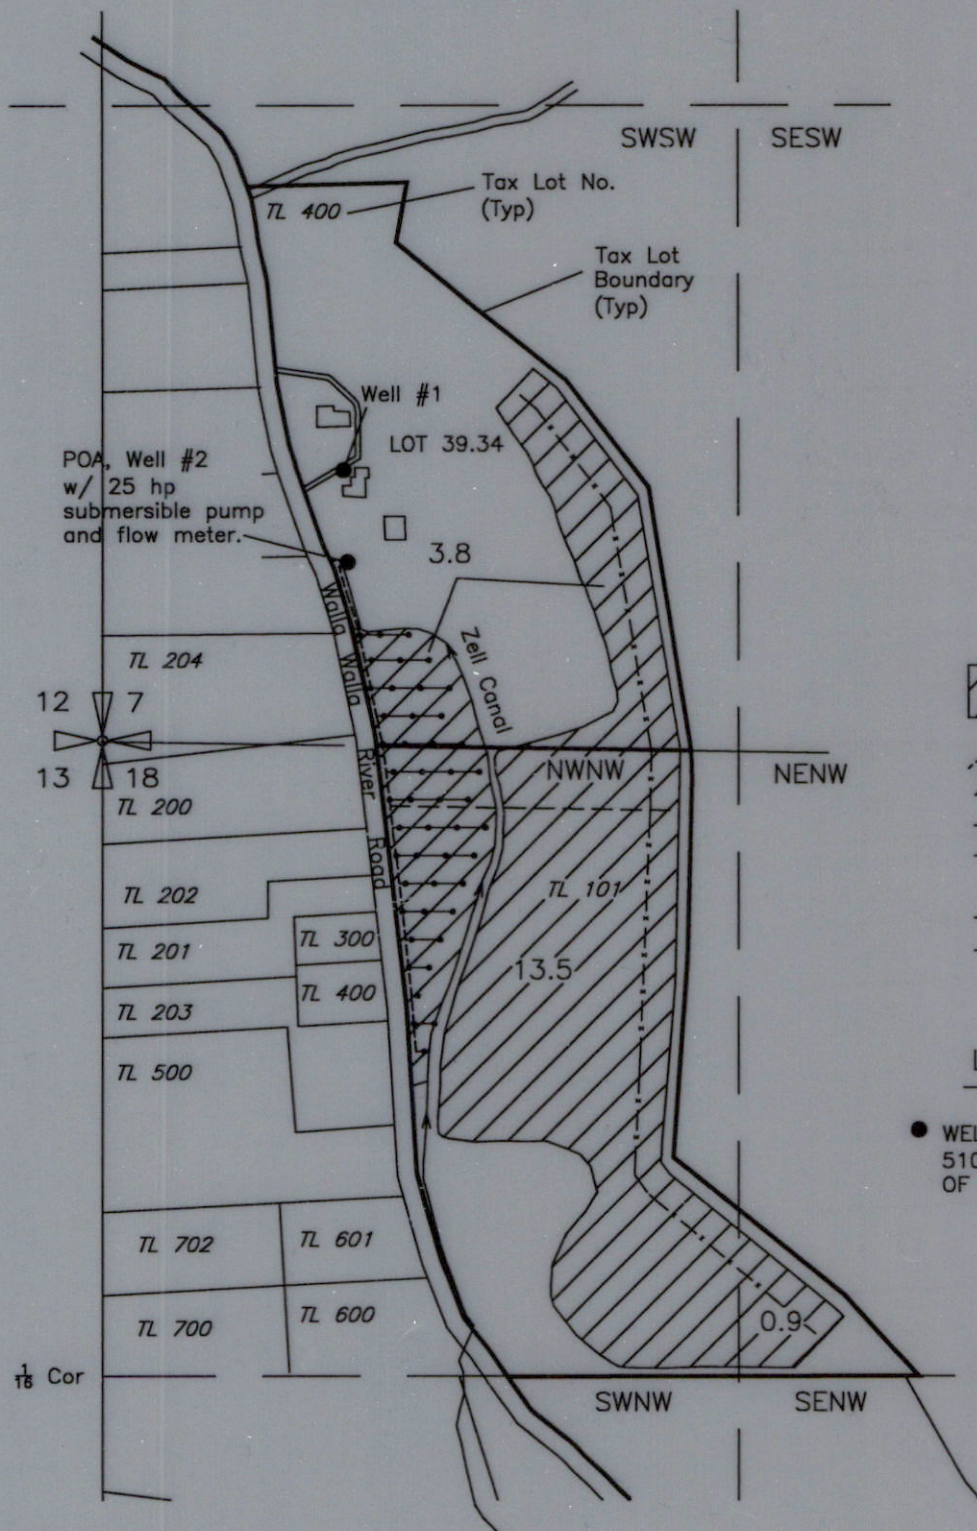


LEGEND

- Area Irrigated
- Acres Irrigated in Qtr Qtr
- Buried Main Pipeline
- Buried Lateral w/ Sprinklers
- Above Ground Main Pipeline
- Above Ground Lateral w/ Sprinklers

LOCATION OF POA

- WELL #2, LOCATED 380'N AND 510'E FROM THE SW CORNER OF SECTION 7

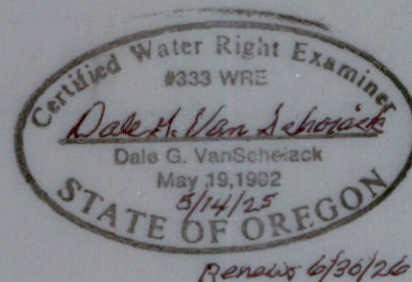

NOTE:  
THE PURPOSE OF THIS MAP IS TO IDENTIFY THE APPROXIMATE LOCATION OF THE WATER RIGHT. IT IS NOT INTENDED TO PROVIDE INFORMATION RELATIVE TO THE LOCATION OF PROPERTY OWNERSHIP BOUNDARY LINES. PIPELINE SIZES AND LOCATIONS WERE PROVIDED BY FARM PERSONNEL AND HAVE NOT BEEN VERIFIED.

DGV Consulting, PLLC  
PHONE (509) 627-8717  
dalevconsulting@gmail.com  
Date: May 12, 2025