



Oregon Water Resources Department
725 Summer Street NE, Suite A
Salem, Oregon 97301
(503) 986-0900
www.oregon.gov/OWRD

Ownership Update for Certificated Rights Only

NO FEES ARE REQUIRED TO SUBMIT THIS FORM

NOTICE: A certificate of water right typically stays with the land. To track water right ownership, the Department requests that this form be submitted to the Department. **To update multiple rights, a separate form is required for each right.** If you have any questions about this form, please contact your local watermaster, or call the Water Resources Department at (503) 986-0900.

Note: Use the assignment form to change ownership on pending applications, permits, transfers, groundwater registrations, or limited licenses.

Current Landowner Information

Name:	Silver Spur Real Estate, LLC, a Delaware limited liability company				
Mailing Address:	655 Deep Valley Dr., Ste 303				
City:	Rolling Hills Estates	State:	CA	Zip:	90274
Phone:	(424) 392-3829	Email:	andychou@koseiadvisors.com		

Property Information

County:	Wheeler County	Township:	6S	Range:	19E	Section:	7, 8, 17, 18
Tax Lot #:	300						
Street Address of Water Right:	N/A						

Water Right Information

Application:	S-65485
Permit:	S-47965
Certificate:	91509

Are all the lands associated with this water right owned by the requestor? ☐ Yes ☒ No

(If no, include a map showing the portion of the water right involved)

Signature and Date

Name of individual completing form:	Laura A. Schroeder on behalf of Silver Spur Real Estate, LLC		
Phone or email:	counsel@water-law.com	Date:	5/13/25
Signature of requestor:			

The Department does not change names on water right certificates. This form will be placed in the file for future reference only. If mailed, the Department will not provide acknowledgment of receipt.


This form can be mailed to the address above or sent by email to wrd_dl_customerservice@water.oregon.gov

Certificate 91509

T. 6 S., R. 19 E., W. M.

P-47965
66497

0.1 acres in
SESE included
in ownership
update

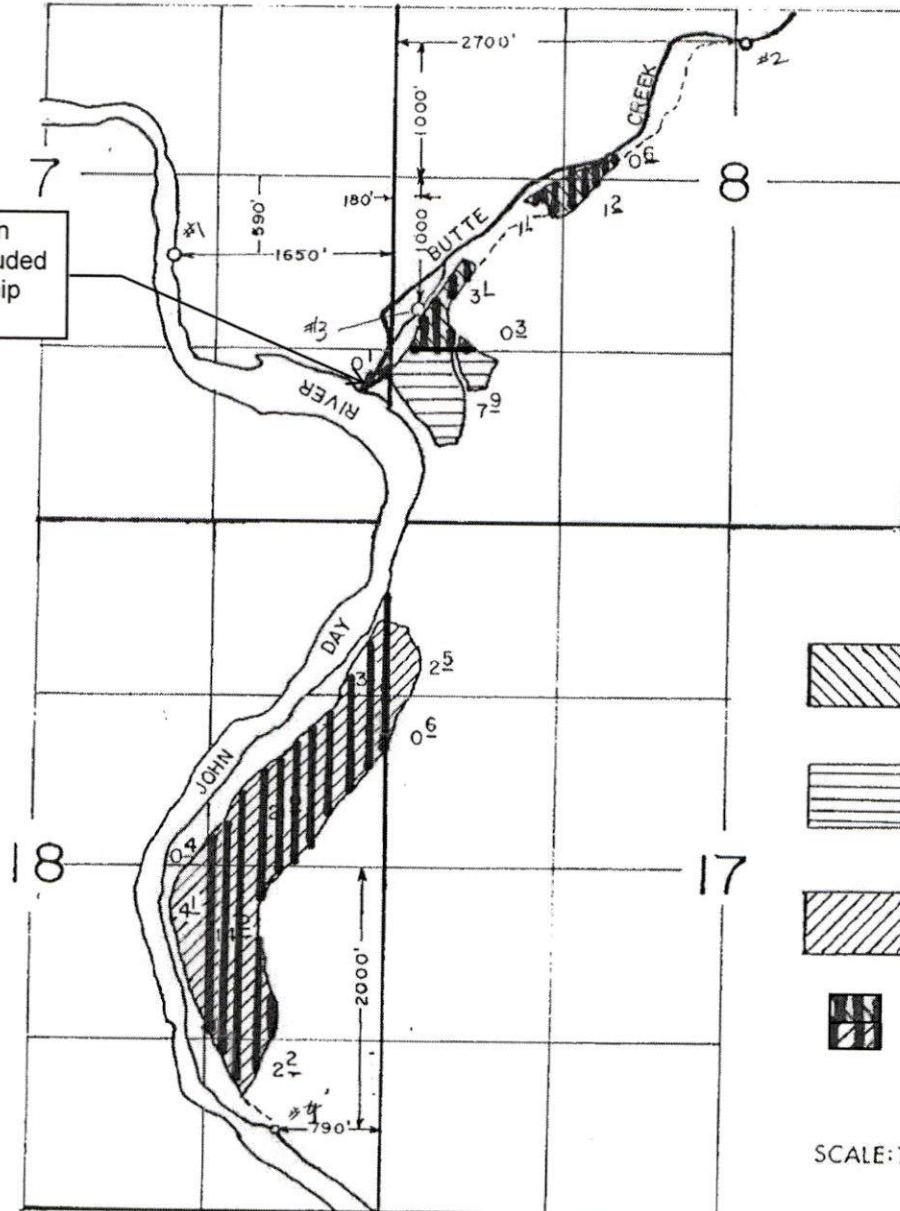

Supplemental
John Day River

Primary
Butte Creek
Supplemental
John Day River

Add. 1/80th
John Day River

Portions involved in
Ownership Update

SCALE: 1" = 1320'

FINAL PROOF SURVEY UNDER

Application No. 65485... Permit No. 47965.....
IN NAME OF

.....STEIWER RANCHES, INC.....

Surveyed MAY..13.. 1987., by V.L.CHURCH.....

Received
MAY 15 2025

OWRD