



Oregon Water Resources Department
725 Summer Street NE, Suite A
Salem, Oregon 97301
(503) 986-0900
www.oregon.gov/OWRD

Ownership Update for Certificated Rights Only

NO FEES ARE REQUIRED TO SUBMIT THIS FORM

NOTICE: A certificate of water right typically stays with the land. To track water right ownership, the Department requests that this form be submitted to the Department. **To update multiple rights, a separate form is required for each right.** If you have any questions about this form, please contact your local watermaster, or call the Water Resources Department at (503) 986-0900.

Note: Use the assignment form to change ownership on pending applications, permits, transfers, groundwater registrations, or limited licenses.

| Current Landowner Information | | | | |
|-------------------------------|--|--------|----------------------------|------------|
| Name: | Silver Spur Real Estate, LLC, a Delaware limited liability company | | | |
| Mailing Address: | 655 Deep Valley Dr., Ste 303 | | | |
| City: | Rolling Hills Estates | State: | CA | Zip: 90274 |
| Phone: | (424) 392-3829 | Email: | andychou@koseiadvisors.com | |

| Property Information | | | | |
|--|----------------|-----------|----|--------------------------|
| County: | Wheeler County | Township: | 6S | Range: 19E Section: 7, 8 |
| Tax Lot #: | 300 | | | |
| Street Address of Water Right: | N/A | | | |
| Water Right Information | | | | |
| Application: | S-41329 | | | |
| Permit: | S-30859 | | | |
| Certificate: | 47034 | | | |
| Are all the lands associated with this water right owned by the requestor? <input type="checkbox"/> Yes <input checked="" type="checkbox"/> No | | | | |
| (If no, include a map showing the portion of the water right involved) | | | | |

| Signature and Date | | |
|-------------------------------------|--|---------------|
| Name of individual completing form: | Laura A. Schroeder on behalf of Silver Spur Real Estate, LLC | |
| Phone or email: | counsel@water-law.com | Date: 5/13/25 |
| Signature of requestor: | | |


The Department does not change names on water right certificates. This form will be placed in the file for future reference only. If mailed, the Department will not provide acknowledgment of receipt.

This form can be mailed to the address above or sent by email to wrd_dl_customerservice@water.oregon.gov

30859
47034

Certificate 47034

T. 6 S., R. 19 E., W.M.

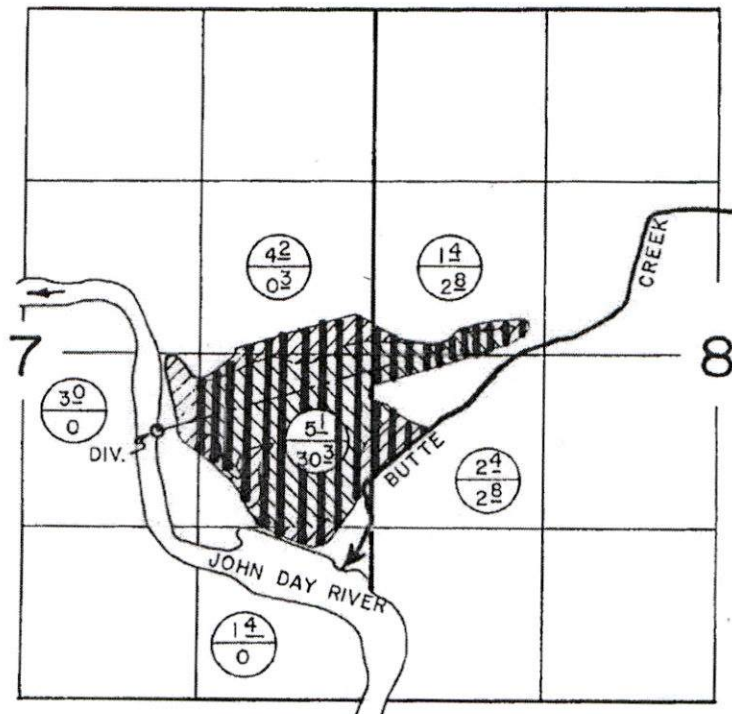

0/0 PRIMARY IRRIGATION - JOHN DAY RIVER
0/0 SUPP'L TO BUTTE CR., CERT.-24961
DIV. PT. LOC.: 590' S. & 1020' E. FROM CTR. SEC. 7

FINAL PROOF SURVEY
UNDER

Application No. 41329 Permit No. 30859
IN NAME OF

STEIWER RANCHES

Surveyed AUG. 24, 1976, by D. NORBY

Received
MAY 15 2025
OWRD

DOV-IJJ-54 JB