

Request for Assignment By Proof of Ownership (If Water Right Holder is Not Available)



Oregon Water Resources Department
725 Summer Street NE, Suite A
Salem, Oregon 97301-1266
(503) 986-0900
www.oregon.gov/owrd

If the Department determines that the application is incomplete, fees have not been paid, or the required documents are not acceptable, the application and all fees submitted will be returned to the applicant.

If for multiple rights, a separate form and fee for each right will be required.

Received
JUN 02 2025

I, Schelhaas Properties, LLC c/o Jim Schelhaas
(Name of Party Requesting Assignment)

PO Box 97 Silver Lake, OR 97638 (541) 848-7999
(Mailing Address) (City) (State) (Zip) (Phone #)

OWRD

- ☐ hereby request assignment of an entire application/permit/transfer order /limited license/groundwater statement;
- ☒ hereby request assignment of a portion of application/permit/transfer order/limited license/groundwater statement;
(You must include a map showing the portion of the application/permit/ transfer order /limited license/groundwater statement to be assigned.)

Application # S-53772 ; Permit # S-40380 ; Transfer Order # _____;

Limited License # _____; Groundwater Statement # _____;

Lawrence and Marjorie Iverson - Deceased
(Name of Current Holder of Record)

(Mailing Address) (City) (State) (Zip) (Phone #)

Note: Write the initials (first letters) of your first and last names at the spots indicated below _____.

- 1) XJS I certify that I am the current owner of the property described in this application, permit, transfer order, limited license, or groundwater statement. I have attached proof of ownership that may include but not be limited to: a copy of the deed to the land, a copy of a land sales contract, a court order or decree, documentation of survivorship of property held jointly. The Department cannot accept a copy of a tax statement.
- 2) XJS I have the legal right to request assignment under OAR 690-310-0280 and 690-320-0060.
- 3) XJS I have not been able to contact the owner(s) of record for the above referenced transaction. I have attached proof acceptable to the Department that notice of the assignment has been given or attempted for each identified property owner not a party to the assignment. ORS 537.220(2) Failure to submit this proof will result in the return of your request. (Proof may include but not be limited to: a copy of returned certified mailing, copy of a Death Certificate, or a court order.)
- 4) XJS I further certify that the information provided herein is true and correct to the best of my knowledge.

Witness my hand this 27 day of May, 2025.
(Day) (Month) (Year)

Signature of Party Requesting Assignment Jim Schelhaas

Failure to provide any of the required information will result in the return of your application.

This certifies assignment and record change at Oregon Water Resources Department effective 8:00 a.m. on date of receipt at Salem, Oregon.


Fee receipt # 145329

For Director by Mary F. Bjork, Program Analyst in Water Rights Division. MFB

The completed "Request for Assignment" form must be submitted to the Department along with the recording fee of \$120.

Part Assign by Proof - Approve
XJS 6-11-2025

40380

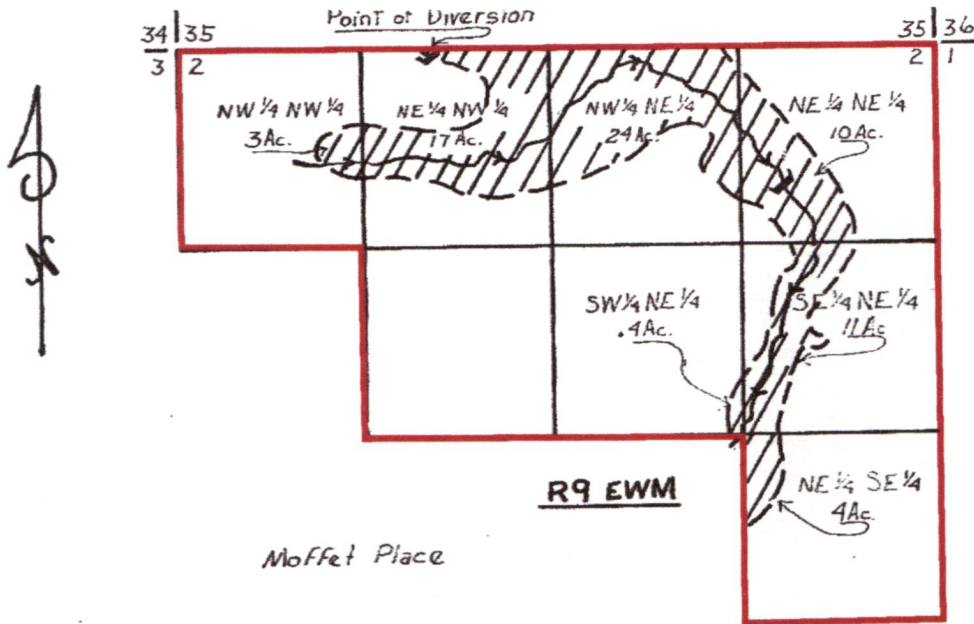

T27S

Received

JUN 02 2025


OWRD

Application No. 53772

Permit No.

40380

T27S

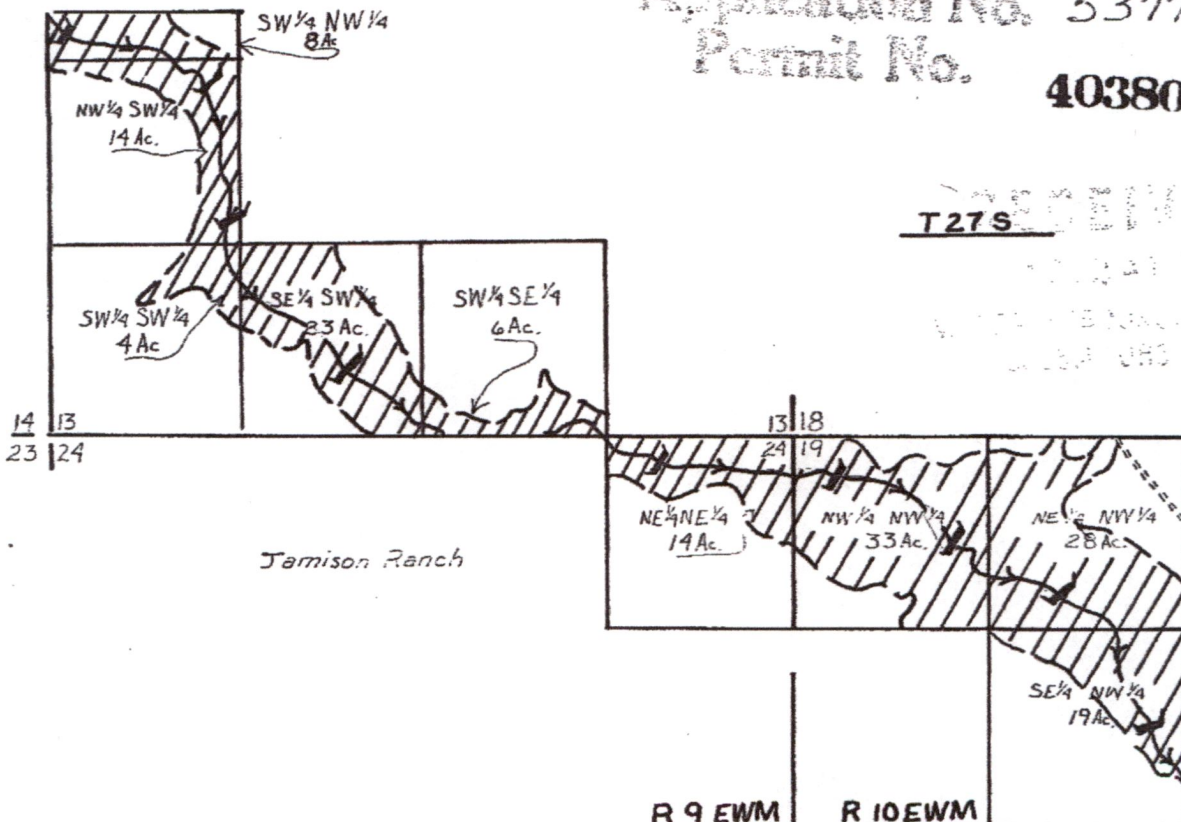

Water Right Map

of LAWRENCE & MARGE IVERSON

Silver Lake, Oregon

Scale 4" = 1 Mile

Aerial Photos ETL-2-073, 2-070, 19-144

Location in Klamath County, Oregon

Creek in approximate location

Legend

Irrigated Areas



Spreader Dam



Williamson River

Assign to Schelhaas Properties 6-11-2025

Request for Assignment By Proof of Ownership (If Water Right Holder is Not Available)



Oregon Water Resources Department
725 Summer Street NE, Suite A
Salem, Oregon 97301-1266
(503) 986-0900
www.oregon.gov/owrd

If the Department determines that the application is incomplete, fees have not been paid, or the required documents are not acceptable, the application and all fees submitted will be returned to the applicant.

If for multiple rights, a separate form and fee for each right will be required.

I, JH Hay Farms, LLC c/o Jim Schelhaas
(Name of Party Requesting Assignment)

PO Box 97 Silver Lake, OR 97638 (541) 848-7999
(Mailing Address) (City) (State) (Zip) (Phone #)

- ☐ hereby request assignment of an entire application/permit/transfer order /limited license/groundwater statement;
- ☒ hereby request assignment of a portion of application/permit/transfer order/limited license/groundwater statement;
(You must include a map showing the portion of the application/permit/ transfer order /limited license/groundwater statement to be assigned.)

Application # S-53772 ; Permit # S-40380 ; Transfer Order # _____;

Limited License # _____; Groundwater Statement # _____;

Lawrence and Marjorie Iverson - Deceased
(Name of Current Holder of Record)

(Mailing Address) (City) (State) (Zip) (Phone #)

Received
JUN 02 2025
OWRD

Note: Write the initials (first letters) of your first and last names at the spots indicated below _____.

- 1) XJS I certify that I am the current owner of the property described in this application, permit, transfer order, limited license, or groundwater statement. I have attached proof of ownership that may include but not be limited to: a copy of the deed to the land, a copy of a land sales contract, a court order or decree, documentation of survivorship of property held jointly. The Department cannot accept a copy of a tax statement.
- 2) XJS I have the legal right to request assignment under OAR 690-310-0280 and 690-320-0060.
- 3) XJS I have not been able to contact the owner(s) of record for the above referenced transaction. I have attached proof acceptable to the Department that notice of the assignment has been given or attempted for each identified property owner not a party to the assignment. ORS 537.220(2) Failure to submit this proof will result in the return of your request. (Proof may include but not be limited to: a copy of returned certified mailing, copy of a Death Certificate, or a court order.)
- 4) XJS I further certify that the information provided herein is true and correct to the best of my knowledge.

Witness my hand this 27 day of May, 2025.
(Day) (Month) (Year)

Signature of Party Requesting Assignment Jim Schelhaas

Failure to provide any of the required information will result in the return of your application.

This certifies assignment and record change at Oregon Water Resources Department effective 8:00 a.m. on date of receipt at Salem, Oregon.


Fee receipt # 145328

For Director by Mary F. Bjork, Program Analyst in Water Rights Division. MBJ

The completed "Request for Assignment" form must be submitted to the Department along with the recording fee of \$120.

Part Assign by Proof - Approve
XJS 6-11-2025

40380

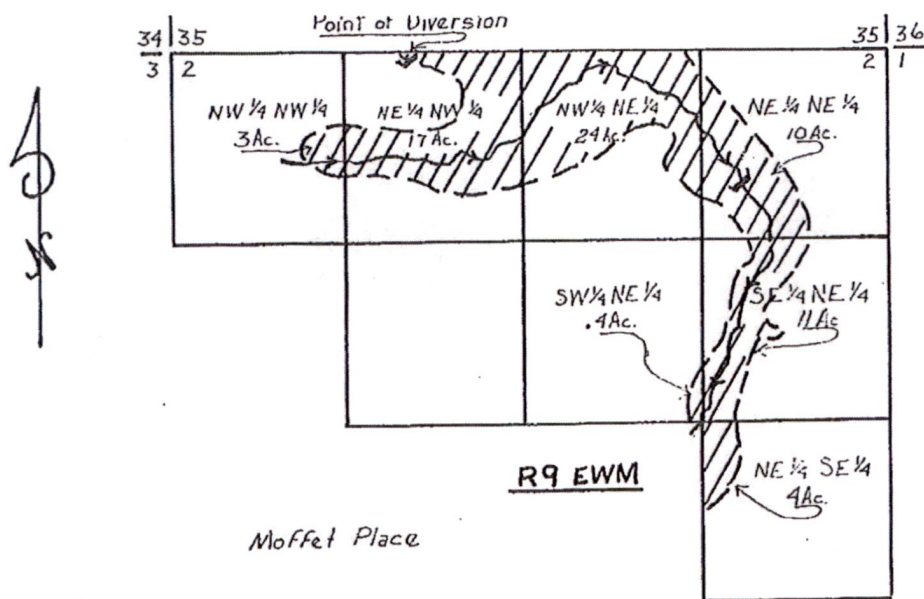

T27S


RECEIVED

JUN 10 2025

OWRD

WATER RESOURCES
DIVISION

Williamson Area Map

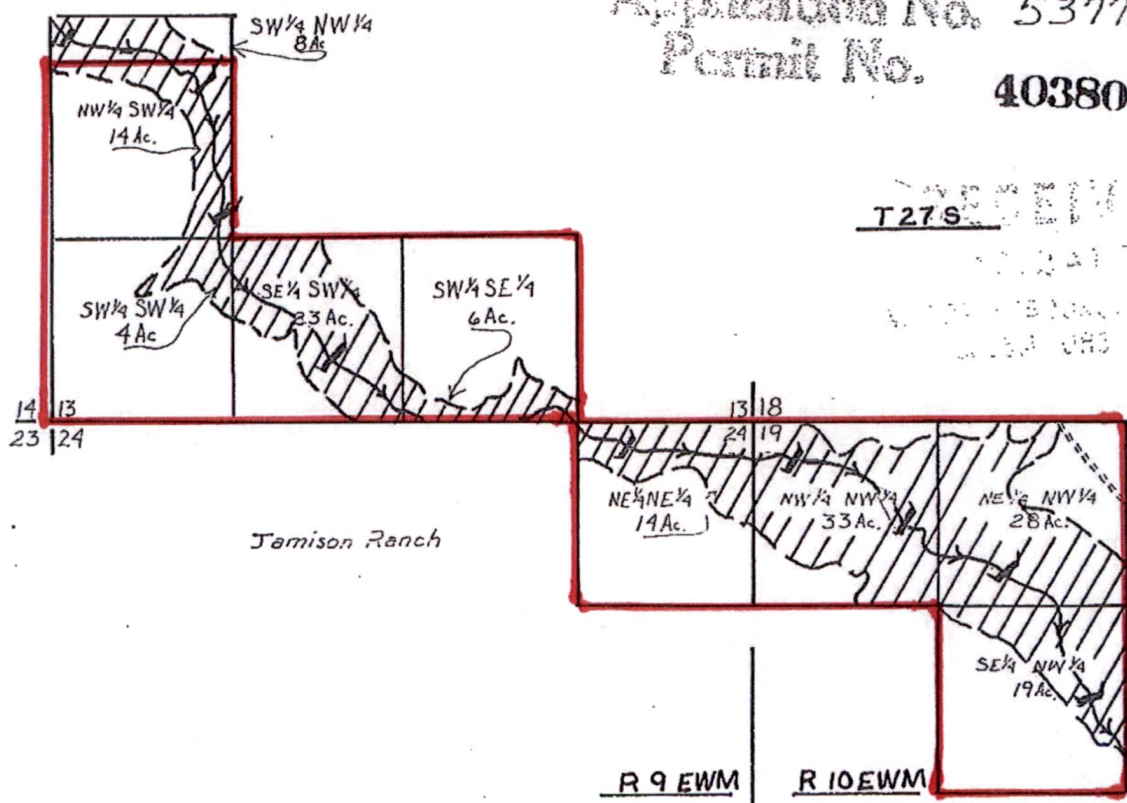

Application No. 53772
Permit No. 40380

T27S

Water Right Map
of
LAWRENCE & MARGE IVERSON
Silver Lake, Oregon
Scale 4" = 1 Mile
Aerial Photos ETL-2-073, 2-070, 19-144
Location in Klamath County, Oregon
Creek in approximate location

Legend
Irrigated Areas
Spreader Dam

Ass'n → JH Hay Farms LLC 6-11-2025