


Received


JUN 16 2025

OWRD

**T2S R16E, WM,
SHERMAN COUNTY, OR**

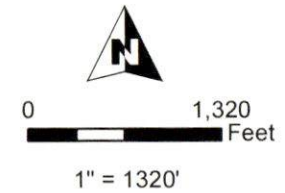

- Well & Meter
-  Place of Use (MUNI)
- Section
- - - - Quarter Quarter

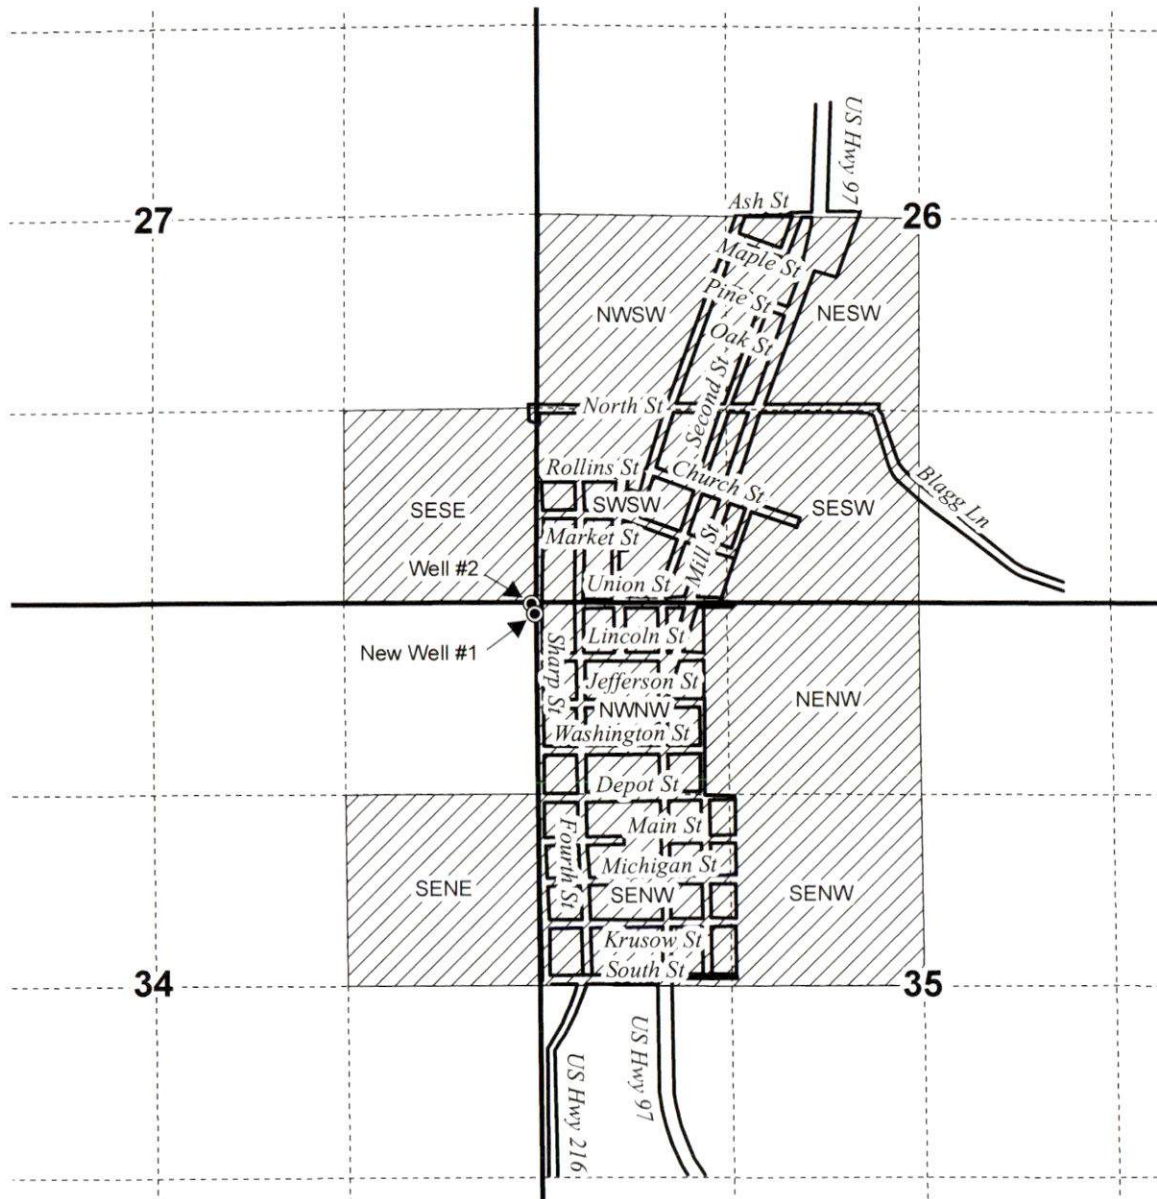

New Well #1 (SHER 50163 / L-72729) Location:
80' S, 11' W of NE Cor Sec 34

Well #2 Location:
10' S, 31' W of NE Cor Sec 34



**CLAIM OF BENEFICIAL USE MAP
City of Grass Valley**

Date: 3/7/2025

T-9885

This map is not intended
to provide legal dimensions
or locations of property
ownership lines.

WATER RIGHT SERVICES, LLC
PO BOX 1830, BEND, OR 97709
WWW.OREGONWATER.US CCB # 197121
johnshort@usa.com 541-389-2837