


T. 20S. R. 3W. SEC. 32

1" = $\frac{100'}{1320'}$

Tax Lot: 304

331' E

43.785253, -123.086597

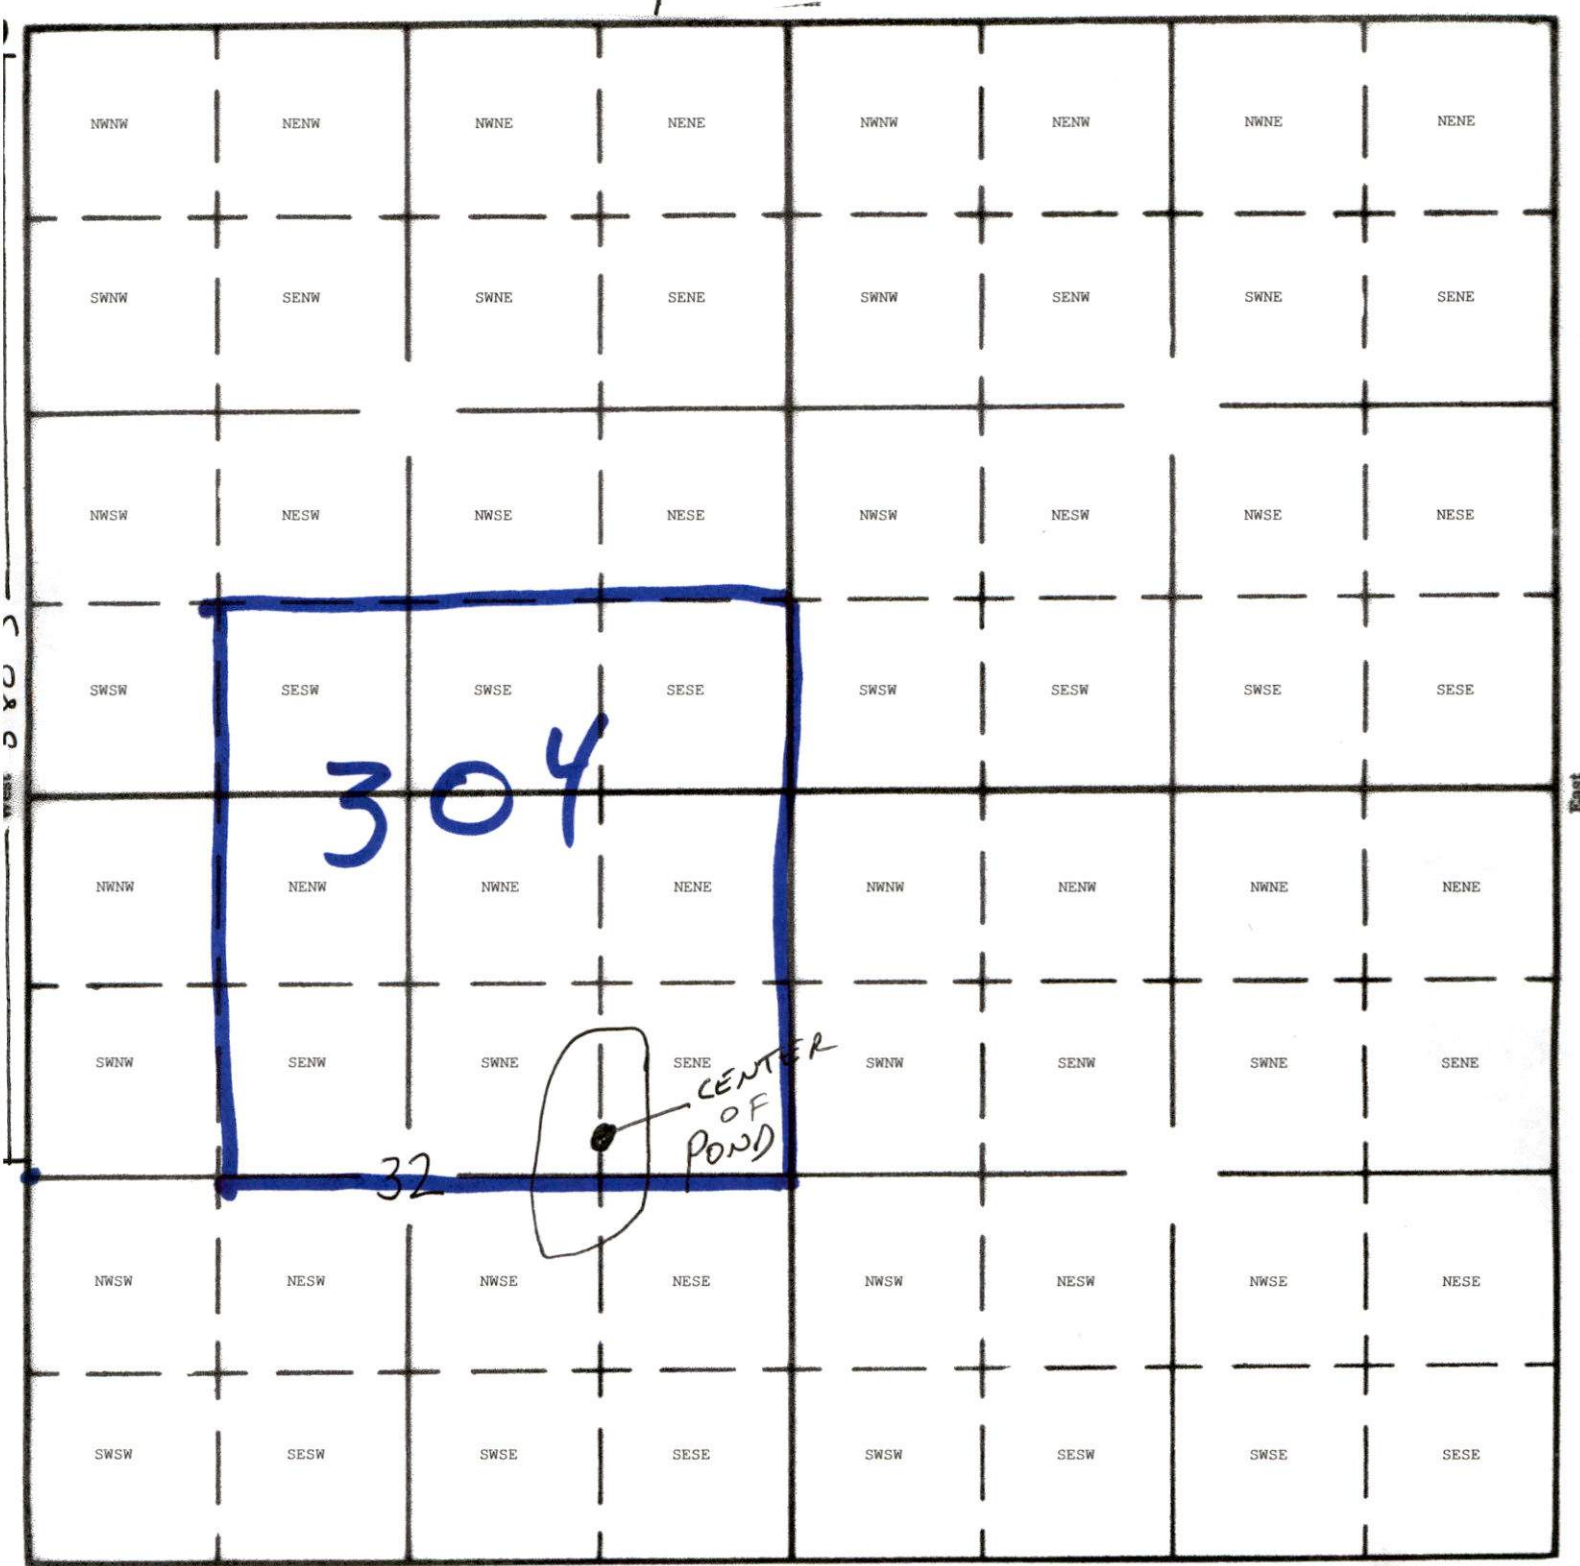

• W 1/4 Section Corner

Received
JUN 23 2025
OWRD

Received
JUN 05 2025
OWRD