

**WELL PERMIT MAP
FOR
APPLICANTS RACHEL JONES AND TOBIN JONES**

Received
2025 JUN 8 1 NIT
OWRD

Received by OWRD
JUN 25 2025
Salem, OR


LEGEND

 North

 = Lot Lines

 1 inch = 400 feet

**1.28 acres to be
irrigated.**

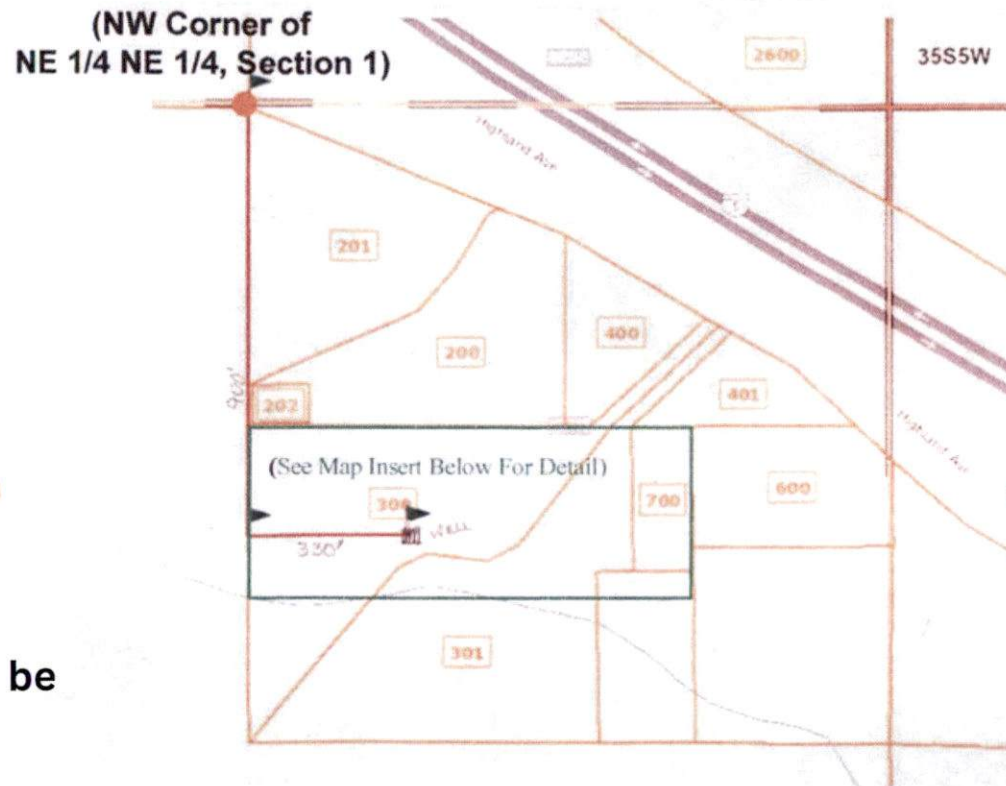

Address: 3326 Highland Avenue, Grants Pass, Josephine County, OR 97526

Township 36S, Range 06W, W.M., Section 01, NE 1/4, NE 1/4, Taxlot 300

MAY 18 2025



5/16/2025, 2:03:03 PM


Received

JUN 18 2025


OWRD

Taxlots

Driveways

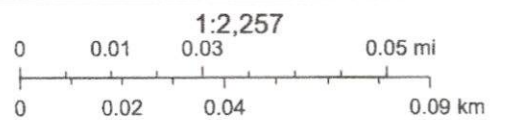

MAP INSERT

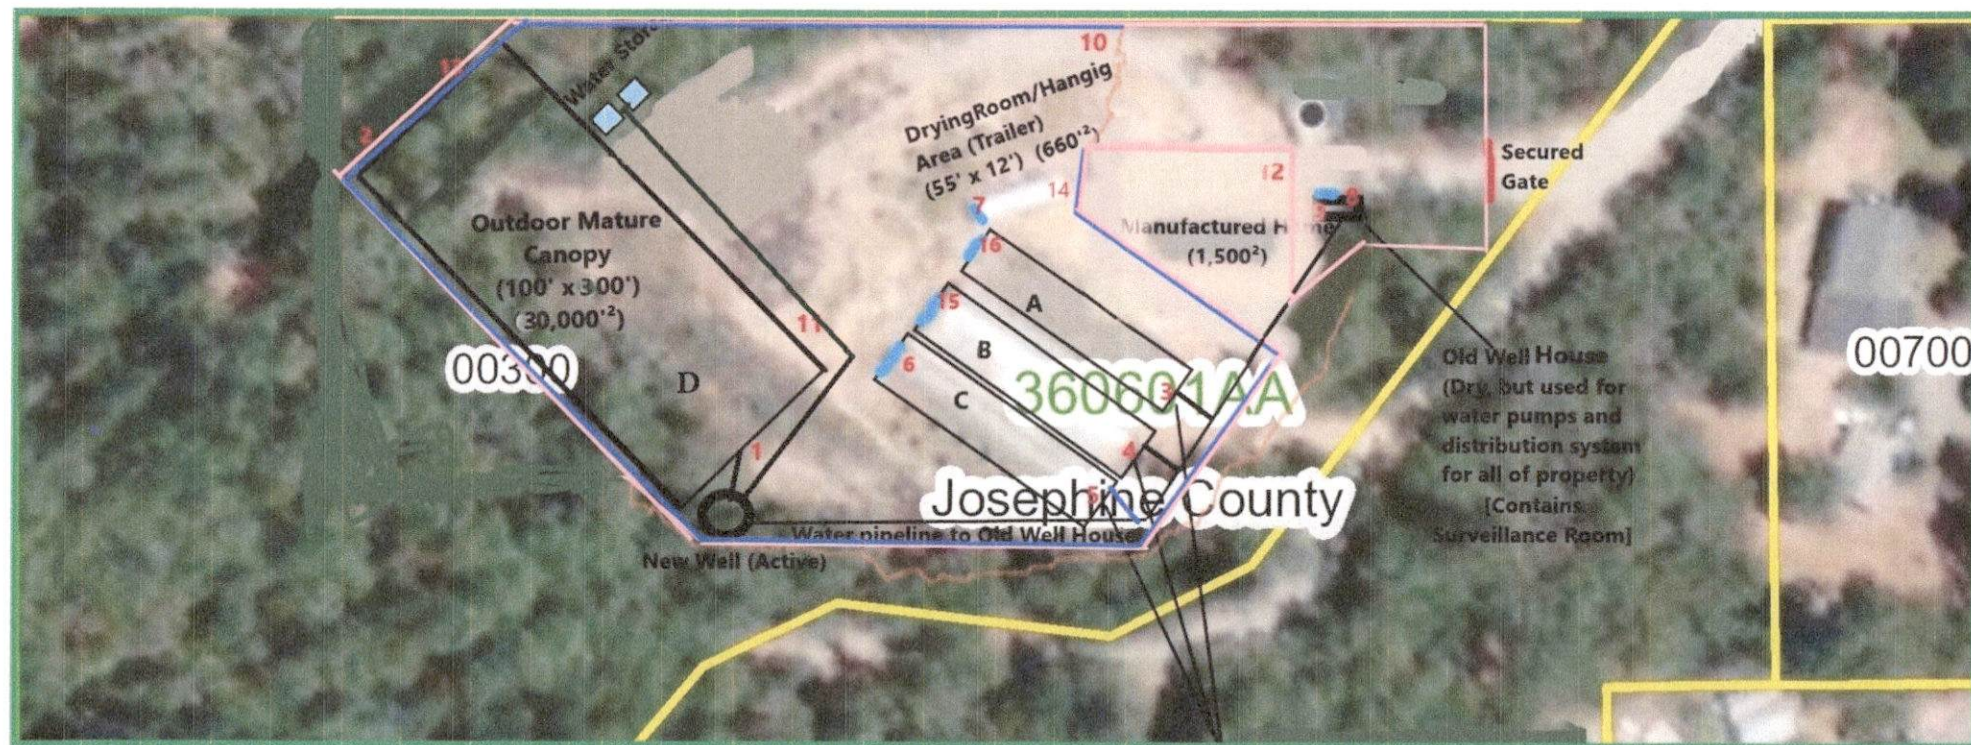

_____ = Steel Fence

1-16 = Security Cameras

3 Greenhouses (A,B,C)
30' x 100' Each
(9,000² feet total)

A,B,C, D = Existing Places of Use of Permitted Water