


# GLT: Evergreen Reservoir Project Overview



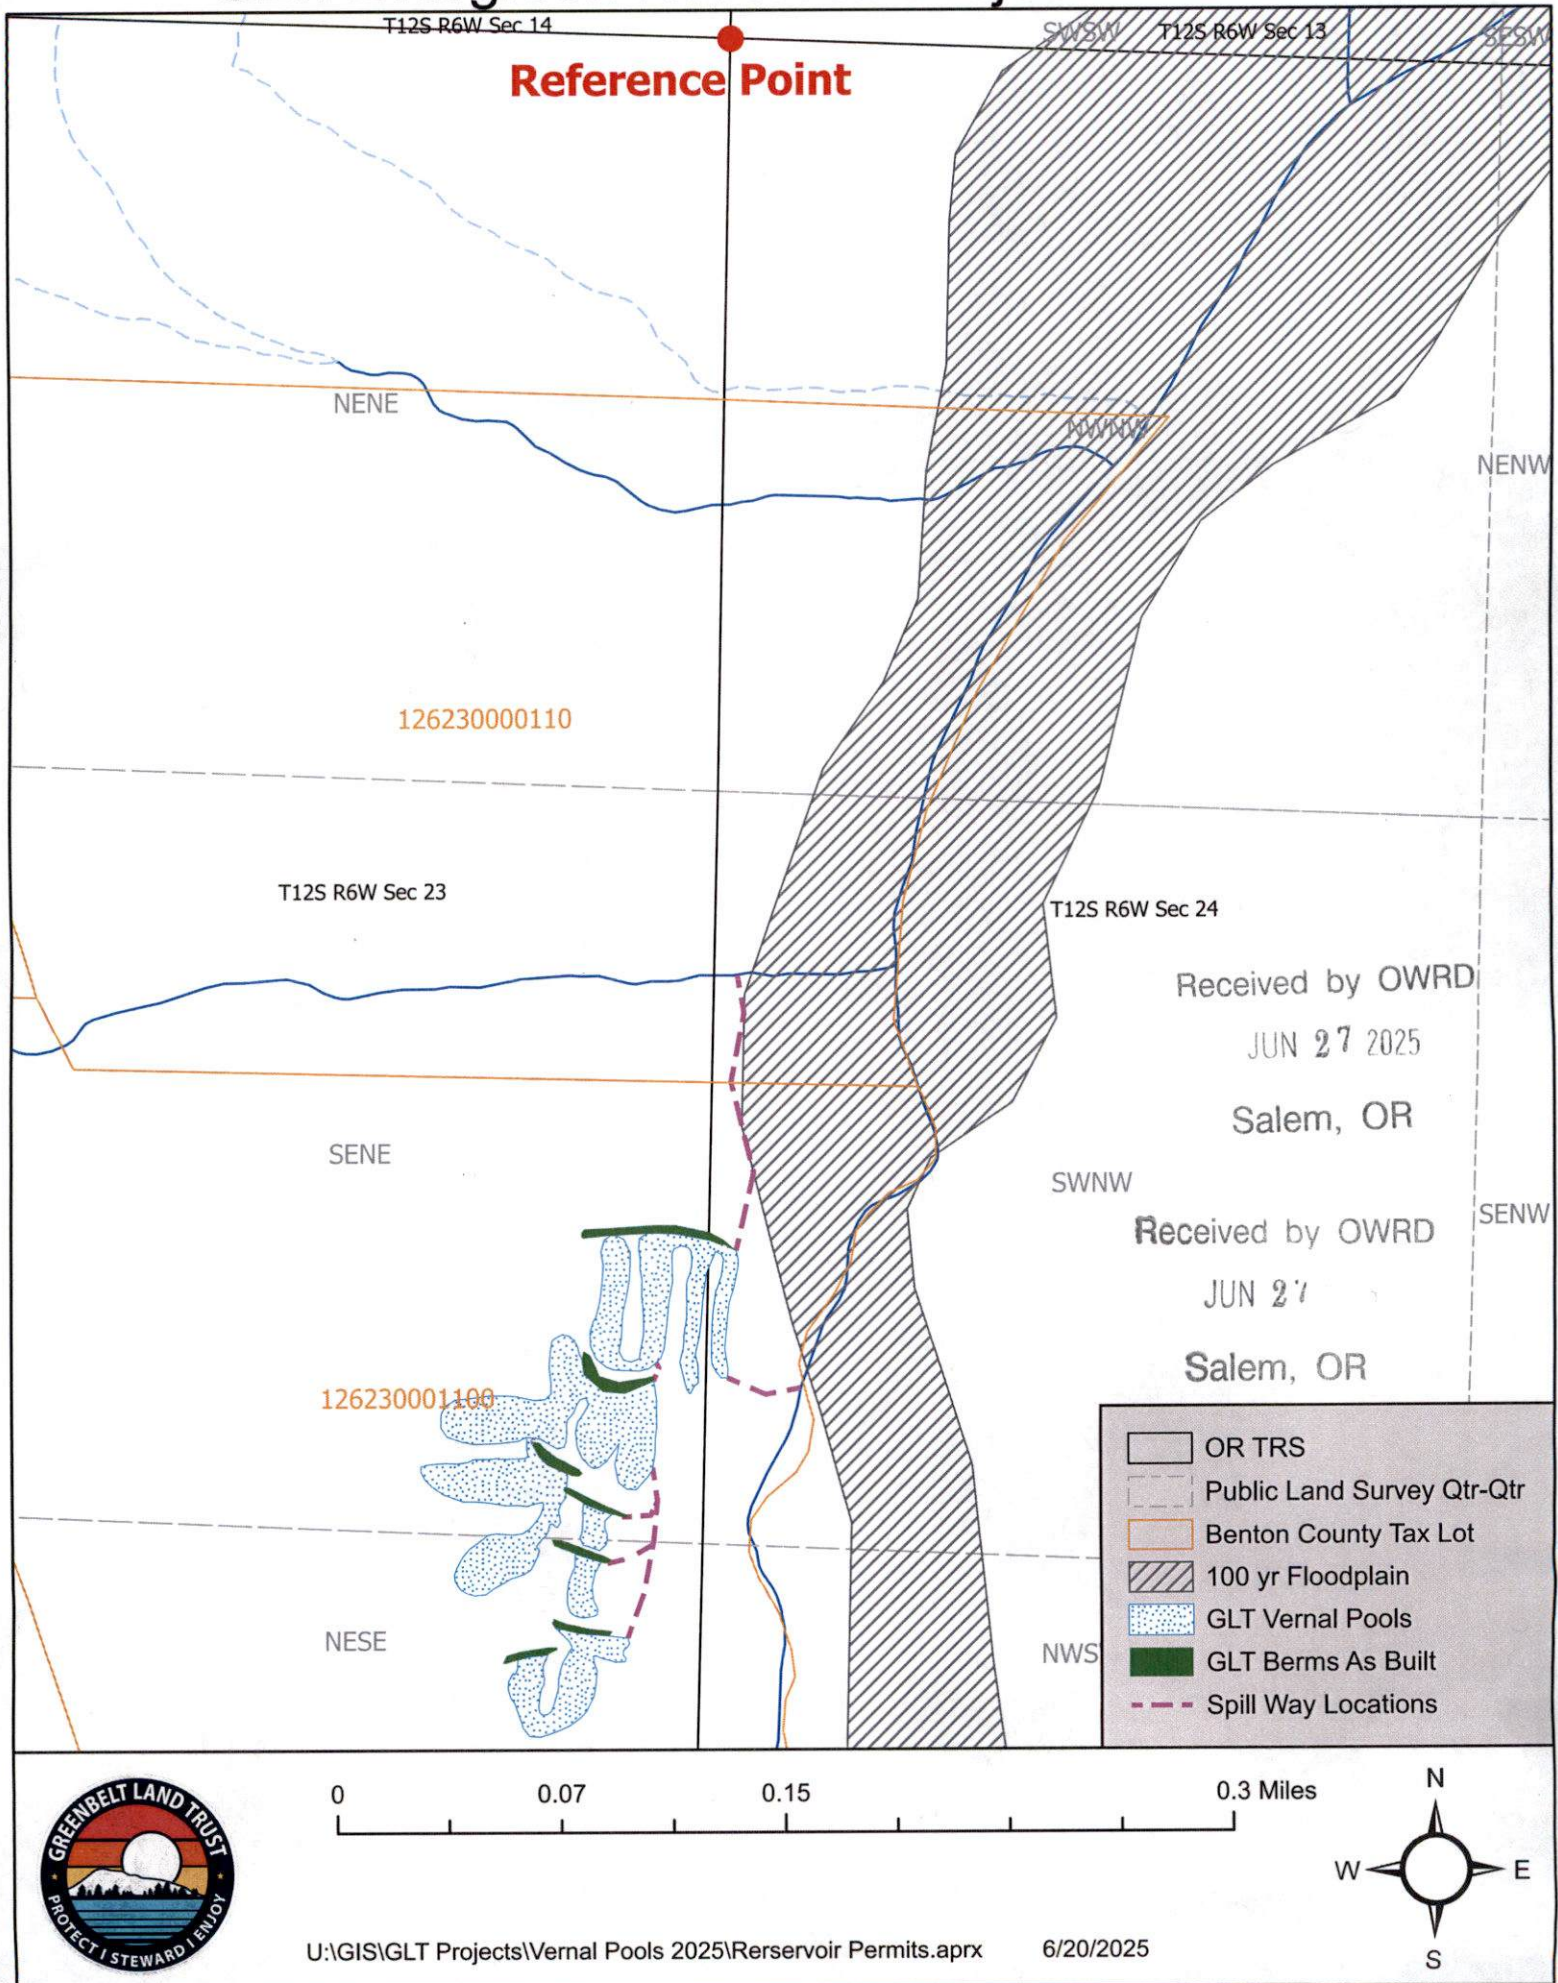

# Evergreen Reservoir Project Area

Received by OWRD  
JUN 27 2025  
Salem, OR

1262300001100

EG-6  
South 2217 ft - West 83 ft

1262300001100

EG-5  
South 2442 ft - West 180 ft

EG-4  
South 2547 ft - West 331 ft

EG-3  
South 2627 ft - West 189 ft

EG-2  
South 2740 ft - West 211 ft

EG-1  
South 2885 ft - West 217 ft

- OR TRS
- Public Land Survey Qtr-Qtr
- 100 yr Floodplain
- GLT Vernal Pools
- GLT Berms As Built
- Spill Way Locations
- Benton County Tax Lot



0 0.04 0.07 0.15 Miles

