

Claim of Beneficial Use
Permit R-15661, Application R-89662

A Water Right held by Nicolas-Jay Estate
Yamhill County



LEGEND


- Point of Diversion (POD)
- ▨ Place of Use (POU) - Storage
- Roads
- Staff Plate
- Tax Lots
- Watercourse

POD Location Description


Center of Reservoir
Located 670 feet South and 1,400 feet West from the
NE corner of Section 21 (NWNE), Township 3 South,
Range 3 West, W.M.

Received
JUL 01 2025

OWRD

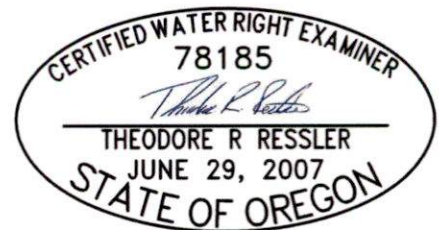

RENEWALS: 12-31-2026

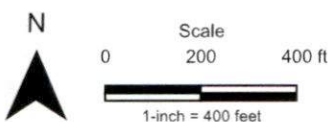

Date: 6/5/2025
Data Sources: BLM, OWRD, ODFW, USGS, Yamhill County.
Disclaimer: This map is not intended to provide legal dimensions
or property ownership lines.

