


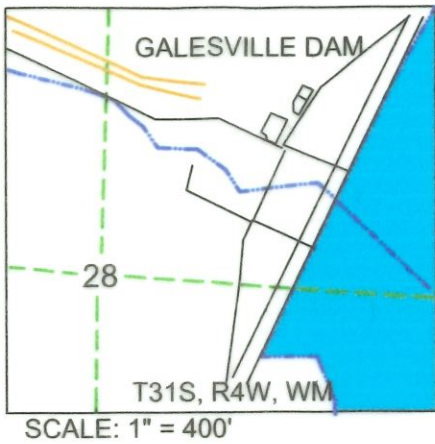

Claim of Beneficial Use

FOR: VLADISLAV O. ZHIRNOV
 BY: NATHAN REED, PE, CWRE
 T30S, R6W, W.M. SECTION 33, GLOT 4
 APPLICATION No.: S-88707
 PERMIT No.: S-55230


DATE OF SURVEY: JUNE 20, 2025

SCALE: 1" = 400'
 Received by OWRD

JUL 01 2025


Salem, OR

POD IS LOCATED 579 FEET SOUTH & 2215 FEET WEST OF NE CORNER OF SECTION 33 AS PROJECTED IN GLOT 4.

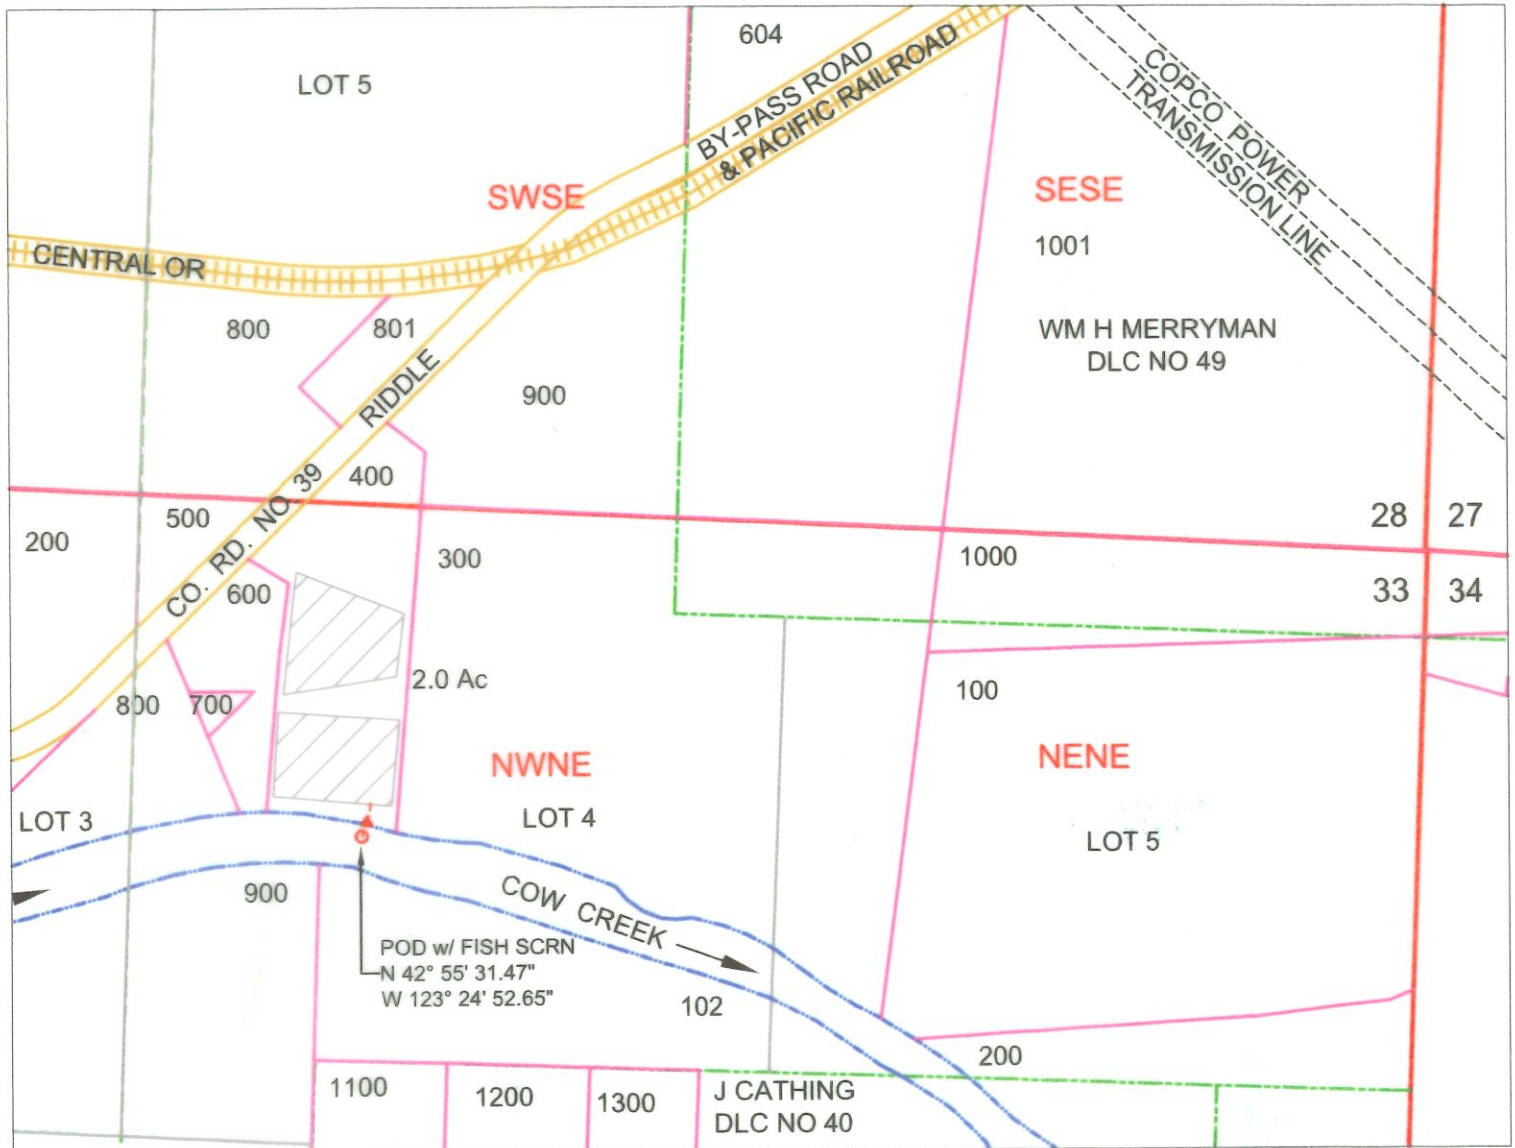

LEGEND

- | | | | |
|--|------------|--|-----------|
| | WATER | | SECTION |
| | PIPE | | QUARTER |
| | PARCEL | | SIXTEENTH |
| | POD | | DLC |
| | PUMP | | GLOT |
| | IRRIGATION | | |

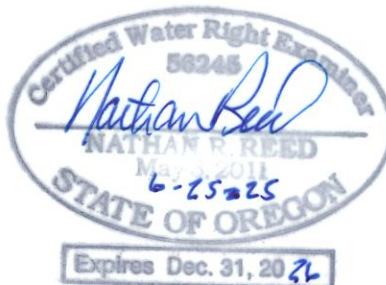

MAP PREPARED FOR:
 VLADISLAV O. ZHIRNOV
 PO BOX 88
 RIDDLE, OR 97469

MAP PREPARED BY:
 NATHAN REED PE, CWRE
 157 WEST BODIE STREET
 ROSEBURG, OR 97471

THE PURPOSE OF THIS MAP IS TO IDENTIFY THE LOCATION OF THE WATER RIGHT. IT IS NOT INTENDED TO PROVIDE INFORMATION RELATIVE TO THE LOCATION OF PROPERTY OWNERSHIP BOUNDARY LINES.