


NE1/4 SEC.34 T.26S. R.3W. W.M.
DOUGLAS COUNTY
1" = 200'

26 3 34A

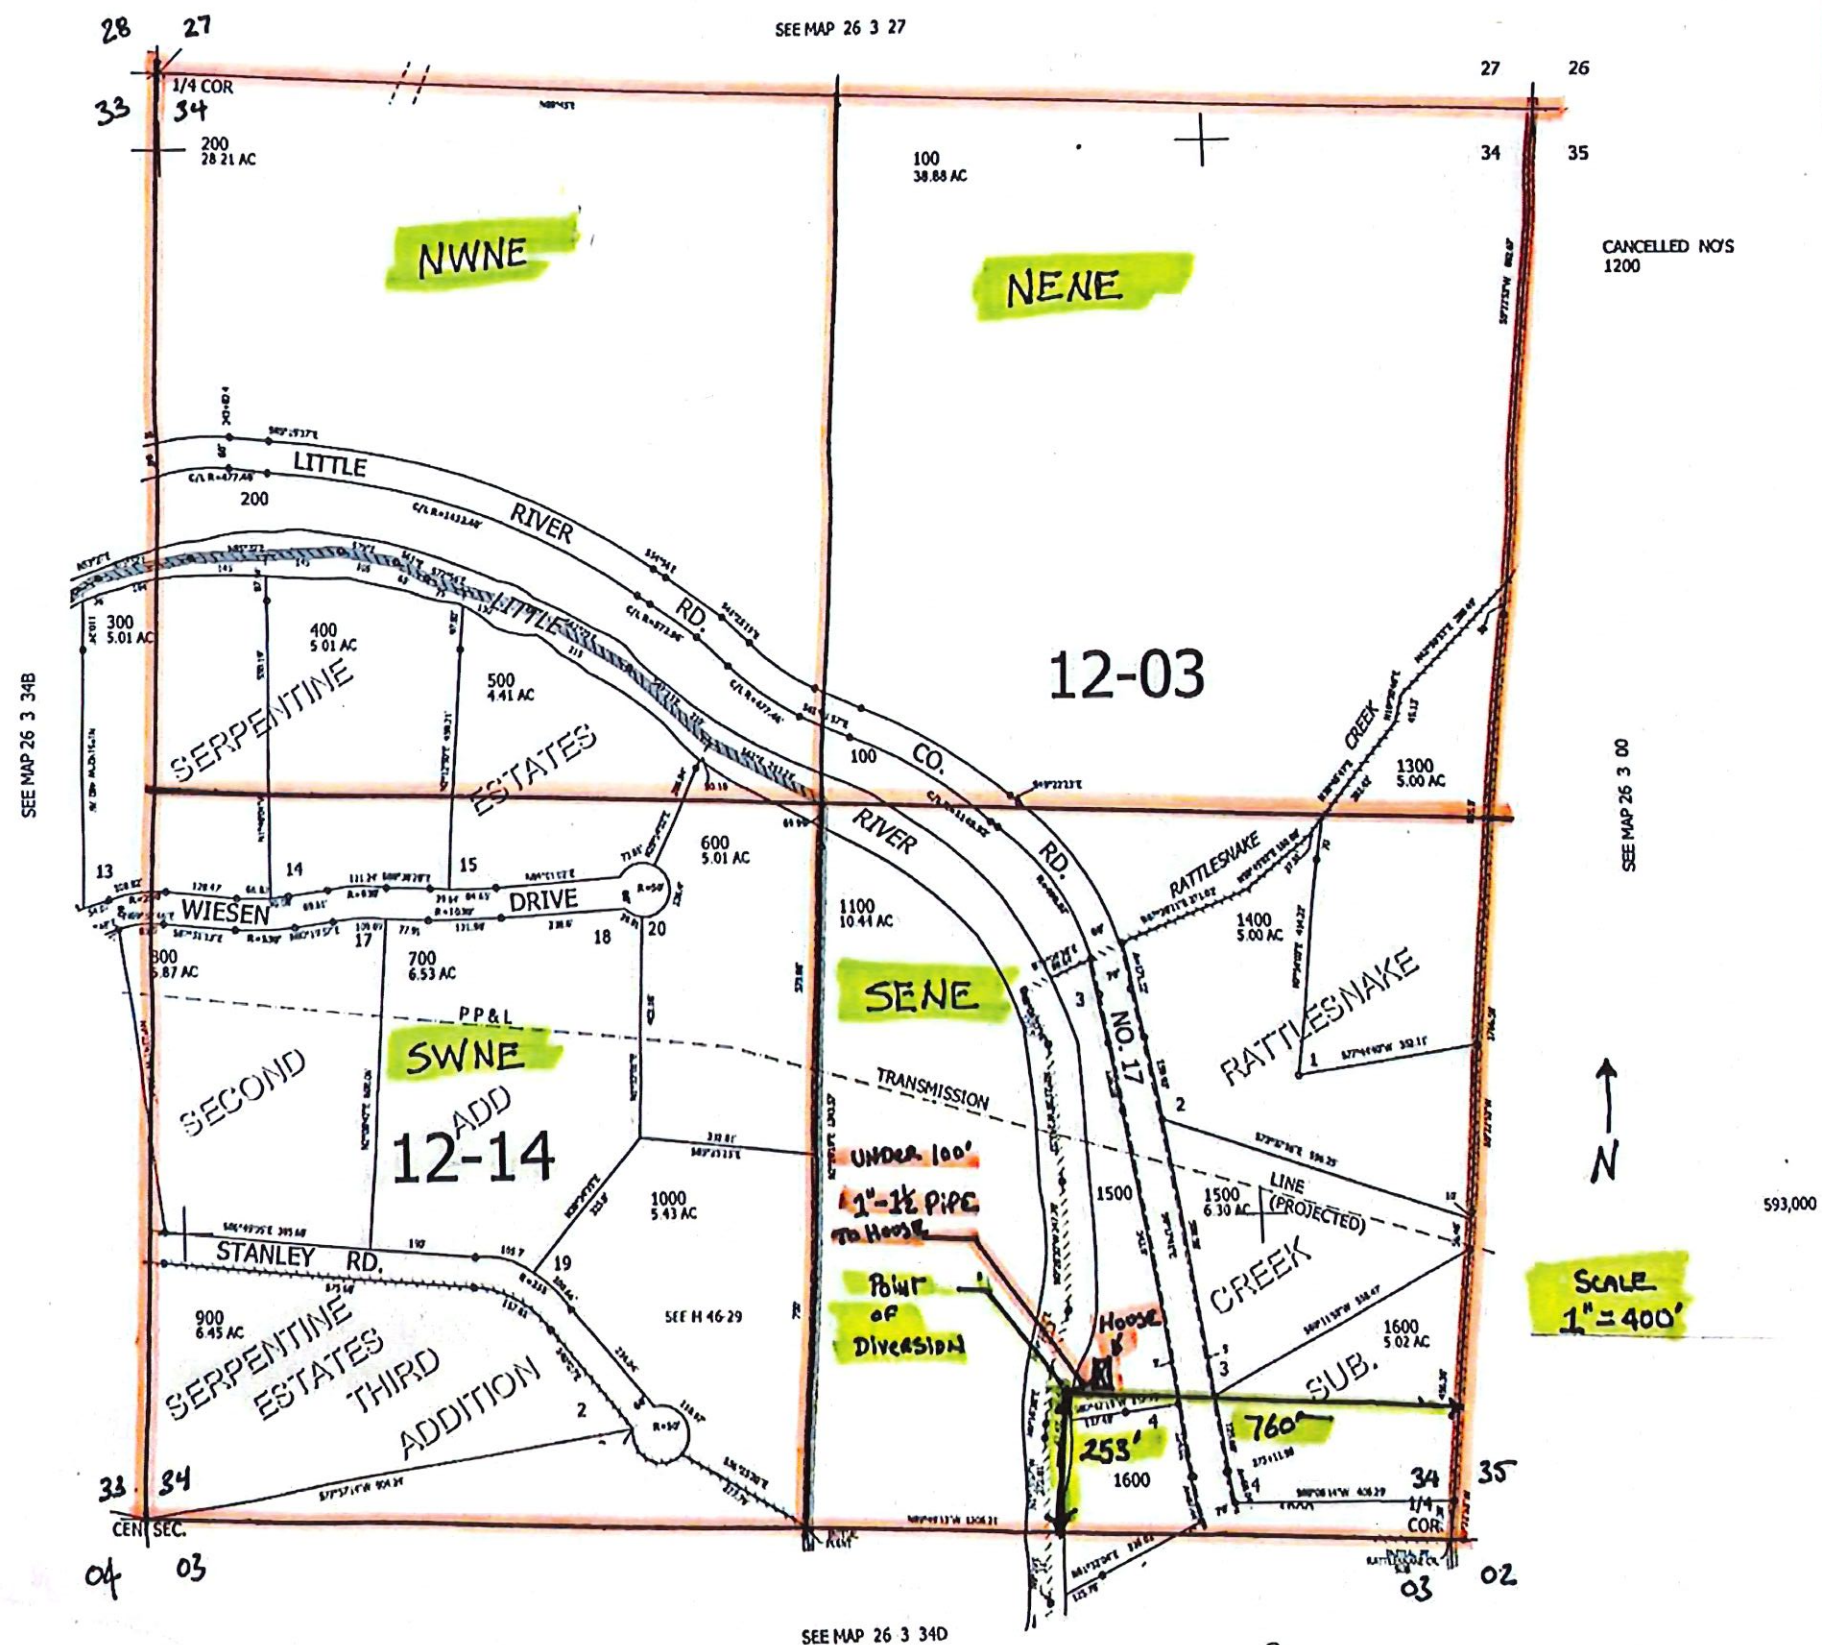

Received by OWRD
JUL 03 2025
Salem, OR

26 3 34A