

# CLAIM OF BENEFICIAL USE MAP

TO ADD PLACE OF USE AND  
A POINT OF APPROPRIATION  
FOR APPLICATION G-9307  
MOSBY FAMILY TRUST

SECTIONS 20, 21, 28-33, TOWNSHIP 31 SOUTH, RANGE 8 EAST, W.M.  
TAX LOTS: 4000, 5600, 5800, AND 5900 AND  
SECTION 6, TOWNSHIP 32 SOUTH, RANGE 8 EAST, W.M.  
TAX LOTS: 100, 200, 300, 400, AND 800  
KLAMATH COUNTY

CANAL

● WELL 3 - (KLAM 675)  
NW 1/4 SW 1/4 SEC 20 T31S R8E, W.M.  
3055' S & 347' E FROM NW CORNER SEC 20.  
POWER METER LOCATED 15' SOUTHEAST FROM WELL

622.7 ACRES PRIMARY IRRIGATION FROM  
WELL 3 & PERMIT G-8842.


789.1 ACRES SUPPLEMENTAL IRRIGATION  
FROM WELL 3 & PERMIT G-8842.

SCALE: 4 INCHES = 1 MILE

Received by OWRD

JUN 16 2025

Salem, OR

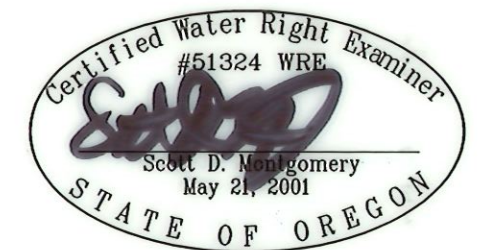

RENEWAL DATE: 12/31/2026

THIS MAP IS FOR THE PURPOSE OF LOCATING  
A WATER RIGHT ONLY AND HAS NO INTENT  
TO PROVIDE LEGAL DIMENSIONS OR THE  
LOCATION OF PROPERTY LINES

PREPARED FOR:  
MOSBY FAMILY TRUST  
294 BITTERROOT DRIVE  
LEWISTOWN, MT 59457

PREPARED BY:



ALL POINTS ENGINEERING AND SURVEYING, INC.  
P.O. BOX 767  
(541) 548-5833  
TERREBONNE, OR 97760  
www.APEandS.com